

FILED

sh

DEC 12 1990

OREGON CORNER RESTORATION FORM


Section 26 Township 22S Range 7W

County DOUGLAS Date 3/90

COUNTY SURVEYOR
DOUGLAS COUNTY, ORE.

Corner Designation

N 1/16

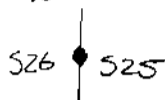

- Condition Report Only
- Not Found
- Renewed
- Unrecorded
- Surveyed In
- Referenced Out


Previous Renewals/Surveys, etc. _____

Monument(s) & Accessories Found: (Condition and Source)

CORNER IS A HAINES T-IRON 0.5 FT ABOVE GROUND IN GOOD CONDITION
 16" D.F. BEARS S 38° W 9.2 FT WELL HEALED FACE AND B.T. TAG
 14" D.F. BEARS N 82° E 26.7 FT WELL HEALED FACE AND B.T. TAG

Monument Detail

Sketch

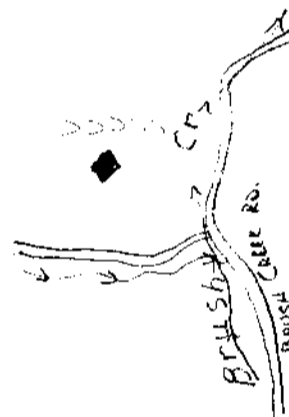

Monument Set (Procedures and Description)

New Accessories

PAINTED FACES AND WROTE B.T. ON TREE TRUNKS OF B.T.'S WITH FLOUR ORANGE PRINT.

Location & Comments

CORNER LIES ON STEEP SOUTH SLOPE APPROX 250 FT SOUTH OF RIDGE
 Compass Declination 19 1/2°
 Firm/Agency LOWE ROCK TIMBER COMPANY
 Address P.O. BOX 1127 ROXBURG
 Party Chief KEN HOFFINE
 Notes _____
 Witness _____

Surveyor's Seal

REGISTERED PROFESSIONAL LAND SURVEYOR
 Ken W. Hoffine
 OREGON JULY 18, 1987
 KEN W. HOFFINE
 2291