

OREGON CORNER RESTORATION FORM

FILED

SK

Section 21 Township 22S Range 9W

DEC 12 1990

County DOUGLAS Date 8/90

COUNTY SURVEYOR
DOUGLAS COUNTY, ORE.

Corner Designation

521

CE 1/16 For SE 1/4

- Condition Report Only
- Not Found
- Renewed
- Unrecorded
- Surveyed In
- Referenced Out

Previous Renewals/Surveys, etc. _____

Monument(s) & Accessories Found: (Condition and Source)



CORNER IS A BRASS CAP SET BY ROBERTS JR. GOOD CONDITION

32" DF STUMP WITH BARK REMOVED, TREATED, COVERED WITH ALUMINUM BEARS S81°E 12.4' TO NAIL IN SIDE OF STUMP

18" DF STUMP WITH BARK REMOVED, TREATED, COVERED WITH ALUMINUM BEARS S6°W 20.3' FT TO NAIL IN FACE 21.2' FT TO MIDDLE OF STUMP

Monument Detail

Sketch

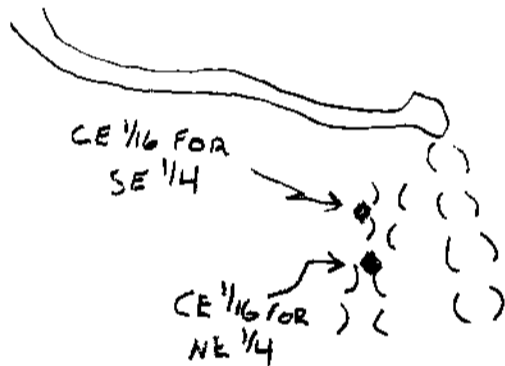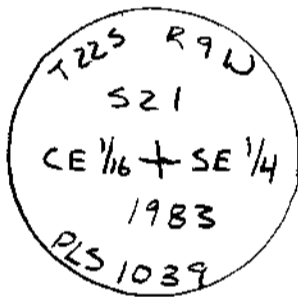

Monument Set (Procedures and Description)

New Accessories

PAINTED FACES AND WROTE B.T. ON STUMPS OF B.T.'S WITH FLOUR ORANGE PAINT

16" DF SWAG BEARS S6°W 4.5' FT TO NAIL (REFERENCED WITH METAL FLASHER)

36" DF STUMP BEARS S31°E 21.2' FT TO NAIL (REFERENCED WITH METAL FLASHER)

Location & Comments

CORNER SITS ON SIDE _____

SLOPE 50 FT SOUTH OF _____

SMALL DRAW AND _____

APPROX 150 FT SE OF _____

THE END OF LOGGING _____

RD. _____

Compass Declination 19 1/2°

Firm/Agency LOWE ROCK

TIMBER COMPANY

Address P.O. Box 1127

ROSEBURG

Party Chief KEN HOFFINE

Notes _____

Witness GARY ANGIOLETT

Surveyor's Seal

