

FILED

DEC 12 1990

OREGON CORNER RESTORATION FORM

Section 21 Township 22S Range 9W

County DOUGLAS Date 8/90

COUNTY SURVEYOR
DOUGLAS COUNTY, ORE.

Corner Designation

S21

CE 1/16 FOR N.E. 1/4

- Condition Report Only
- Not Found
- Renewed
- Unrecorded
- Surveyed In
- Referenced Out



Previous Renewals/Surveys, etc. _____

Monument(s) & Accessories Found: (Condition and Source)

CORNER IS A BRASS CAP SET BY ROBERTS IN GOOD CONDITION
 38" DF STUMP WITH BARK REMOVED, TREATED AND ALUMINUM COVERING
 BEARS N 54° E 50.2 FT TO NAIL IN BOTTOM OF STUMP
 26" ALDER STUMP TREATED AND COVERED WITH ALUMINUM BEARS
 S 9° E 18.2 FT TO NAIL IN FACE TRSS WAS BARK SCRIBED
 MOST OF THE BARK HAS BEEN TORN OFF BY LOGGING, ONLY
 B.T. IS VISIBLE ON BOTTOM OF STUMP.

Monument Detail

Sketch

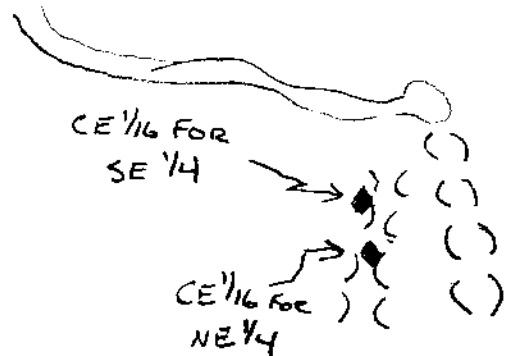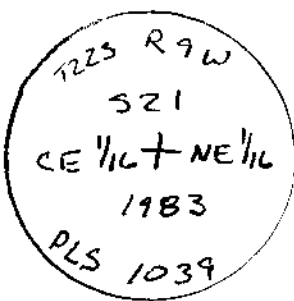

Monument Set (Procedures and Description)

New Accessories

PAINTED FACES AND WROTE B.T. ON STUMPS WITH FLOUR
 ORANGE PAINT.
 34" DF SWAG BEARS N 39° E 19.2 FT TO NAIL (REFERENCED BY METAL FLASHER)
 30" DF SWAG BEARS S 66° E 13.2 FT TO NAIL (REFERENCED BY METAL FLASHER)
 22" ALDER STUMP BEARS S 41° W 17.4 FT TO NAIL (REFERENCED BY METAL FLASHER)

Location & Comments

CORNER LBS IN BOTTOM OF SMALL DRAIN
 APPROX 200 FT S E OF THE END OF THE LOGGING RD. CLEAR CUT ON ALL SIDES OF CORNER

Compass Declination 19 1/2°
 Firm/Agency LONG ROCK TIMBER COMPANY
 Address P.O. BOX 1127 ROSEBURG
 Party Chief KEN HOFFINE
 Notes _____
 Witness GARY ANGIOLRT

REGISTERED
 PROFESSIONAL
 LAND SURVEYOR

Ken W. Hoffine

OREGON
 JULY 16, 1987
 KEN W. HOFFINE
 2291