

FILED

DEC 13 1990

OREGON CORNER RESTORATION FORM

Section 6 Township 23S Range 6W

County DOUGLAS Date 10/90

COUNTY SURVEYOR
DOUGLAS COUNTY, ORE

Corner Designation

T23S R6W
S32
S6 | S5

- Condition Report Only
- Not Found
- Renewed
- Unrecorded
- Surveyed In
- Referenced Out



Previous Renewals/Surveys, etc. _____

Monument(s) & Accessories Found: (Condition and Source)

- ✓ CORNER IS A GLO BRASS CAP IN LOOSE ROCK; CORNER MOVES SLIGHTLY
- ✓ 54" (ORIGINAL) D.F. STUMP BEARS S25°E 7.0 FT BURNED OUT SCAR FACE, AND TWO BLM B.T. TAGS (DISTANCE TO MIDDLE OF STUMP)
- ✓ 20" DECAYED HEMLOCK STUB 6 FT HIGH BEARS S29°E 53 8 FT (BLM RECORD S31°W 79 1ks) SCRIBING VISIBLE
- ✓ 20" HEMLOCK BEARS N27°E 18.1 FT WELL HEALED FACE AND COUNTY B.T. TAG

Monument Detail

Sketch

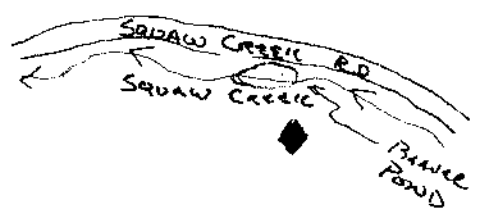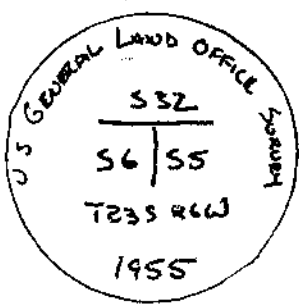

Monument Set (Procedures and Description)

New Accessories

PAINTED FACES AND WROTE B.T. ON TREE TRUNKS ON B.T.'S WITH FLOUR ORANGE PAINT.

Location & Comments

CORNER SITS ON STEEP
 NORTH SLOPE APPROX
 100 FT SOUTH OF SQUAW
 CREEK WITH LARGE
 BEAVER POND

Compass Declination 19 1/2
 Firm/Agency LONG ROCK
TIMBER
 Address P.O. BOX 1127
ROSEBURG
 Party Chief KEN HOFFINE
 Notes _____
 Witness GARY ANGIOLET

Surveyor's Seal

