

FILED

DEC 13 1990

OREGON CORNER RESTORATION FORM

Section 6 Township 23S Range 6W

County _____ Date 10/90

COUNTY SURVEYOR
DOUGLAS COUNTY, ORE.

Corner Designation

T22S R6W
S31
S1|S6
RTW R6W
T23S

- Condition Report Only
- Not Found
- Renewed
- Unrecorded
- Surveyed In
- Referenced Out

Previous Renewals/Surveys, etc. _____


Monument(s) & Accessories Found: (Condition and Source)

- ✓ CORNER IS A 610 BRASS CAP 1 FT ABOVE GROUND IN GOOD CONDITION
- HAINES T-IRON BEARS S37³/₄°E 13³/₈ FT
- 29" DF BEARS S25°W 63³/₈ FT, WELL HEALED FACE AND B.T. TAG
- 32" DF BEARS S65°W 61¹/₈ FT, WELL HEALED FACE, HAINES BRASS WASHER, AND WE PUT UP A LONG ROCK TIMBER LOCATION TAG
- 50" DF BEARS N86°E 54⁵/₈ FT, WELL HEALED FACE, HAINES BRASS WASHER, AND WE PUT UP A LONG ROCK TIMBER LOCATION TAG

#48 T23-1
#8 T23-6
NO RECORD

Monument Detail

Sketch

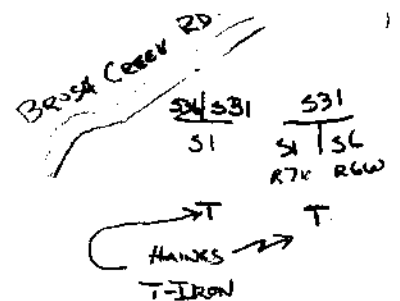

Monument Set (Procedures and Description)

New Accessories

PAINT FACES AND WROTE B.T. ON TREE TRUNKS OF B.T.'S WITH FLOOR ORANGE PAINT

Location & Comments

CORNER LIES ON 40% WEST SLOPE APPROX 105 FT EAST OF S31|S31 CURVING CORNER AND APPROX 205 FT EAST OF BRUSH CREEK RD

Compass Declination 19¹/₂
 Firm/Agency LONG ROCK TIMBER COMPANY
 Address P.O. BOX 1127 ROSEBORG
 Party Chief KEN HOFFINE
 Notes _____
 Witness GARY ANGIOLET

Surveyor's Seal



#174 T23-7 ✓
#89 T23-6 ✓