

FILED

JK

DEC 13 1990

OREGON CORNER RESTORATION FORM

Section 6 Township 23S Range 6W

County DOUGLAS Date 10/90

COUNTY SURVEYOR
DOUGLAS COUNTY, ORE.

Corner Designation

E 1/16

S 6 ONLY

- Condition Report Only
- Not Found
- Renewed
- Unrecorded
- Surveyed In
- Referenced Out

Previous Renewals/Surveys, etc. _____

Monument(s) & Accessories Found: (Condition and Source)


CORNER IS A HAINES T-IRON 0 3/4 FT ABOVE GROUND IN GOOD CONDITION

41" D.F. BEARS N 71° E 5 3/4 FT BARK SCRIBED AND HAINES BEARS WASHER, PUT UP LOCATION TAG

30" D.F. BEARS S 37° E 17 3/4 FT BARK SCRIBED PUT UP LOCATION TAG

Monument Detail

Sketch

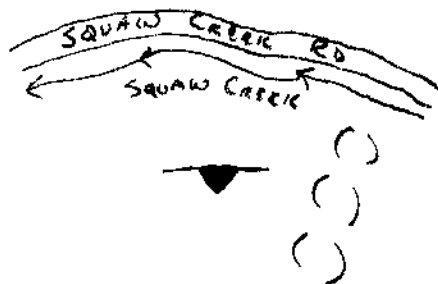

Monument Set (Procedures and Description)

New Accessories

PAINTED FACES AND WROTE P.I.T. ON TAPE TRONICS OF B.T.'S WITH FLOUR ORANGE PAINT

Location & Comments

CORNER LIES ON NW 50% SLOPE APPROX 70 FT SE OF FLAT BEACH AND APPROX 130 FT WEST OF RIDGE TOP

Compass Declination 19 1/2°

Firm/Agency LONG ROCK TIMBER COMPANY

Address P.O. BOX 1127 ROSELBURG

Party Chief KEN W. HOFFINE

Notes _____

Witness GARY ANGIOLET

Surveyor's Seal

REGISTERED
PROFESSIONAL
LAND SURVEYOR

Ken W Hoffine

OREGON
JULY 16, 1987
KEN W. HOFFINE
2201

X