

FILED

DEC 13 1990

OREGON CORNER RESTORATION FORM

Section 12 Township 23S Range 6W

COUNTY SURVEYOR
DOUGLAS COUNTY, ORE.

County DOUGLAS Date 4/90

Corner Designation

E 1/16
S1
—○—
S12

- Condition Report Only
- Not Found
- Renewed
- Unrecorded
- Surveyed In
- Referenced Out


Previous Renewals/Surveys, etc.

Monument(s) & Accessories Found: (Condition and Source)

CORNER IS A RLM BRASS CAP IN GOOD CONDITION
22" D.F. BEARS N20 1/2° E 43.8 FT WELL HEALED FACE AND B.T. TAG
19" D.F. BEARS S24° W 13.5 FT WELL HEALED FACE AND B.T. TAG

Monument Detail

Sketch

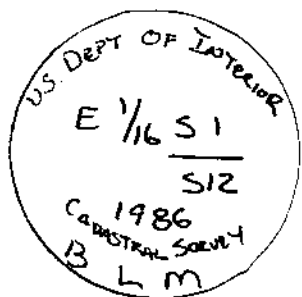

Monument Set (Procedures and Description)

New Accessories

PAINTED FACES AND WROTE B.T. ON TREE TRUNKS OF B.T.'S WITH FLUOR ORANGE PAINT.

Location & Comments

CORNER IS SURROUNDED BY 8"-12" ROCKS NEAR FOOT OF STEEP S.W. SLOPE ON BRUSHY 10% SLOPE. APPROX 3 CHAINS N.E. OF NEW RD CONSTRUCTION. THIS CORNER IS STILL PENDING APPROVAL

Compass Declination 19 1/2°
Firm/Agency LONG ROCK TIMBER COMPANY
Address P.O. BOX 1127 ROSEBURG
Party Chief KEN HOFFINE
Notes
Witness GARY ANGILETT

Surveyor's Seal

