

FILED

DEC 17 1990

OREGON CORNER RESTORATION FORM

Section 26 Township 26S Range 8W

County DOUGLAS Date 3/90

COUNTY SURVEYOR
DOUGLAS COUNTY, ORE.

Corner Designation

S26 1/4 COR.
◆
S35

- Condition Report Only
- Not Found
- Renewed
- Unrecorded
- Surveyed In
- Referenced Out

Previous Renewals/Surveys, etc.

Monument(s) & Accessories Found: (Condition and Source)

REN. #22


CORNER IS A 1 1/2" IRONPIPE IN GOOD CONDITION

29" DE BEARS N 1° W 42 3/4 FT, WELL HEALED FACE WITH B.T. TAG

23" DE BEARS S 58° W 8 1/2 FT, WELL HEALED FACE WITH 2 B.T. TAGS

Monument Detail

Sketch

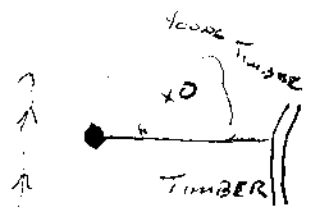

Monument Set (Procedures and Description)

New Accessories

PAINTED FACES AND WROTE B.T. ON TREE TRUNKS OF B.T.'S WITH FLUOR. ORANGE PAINT.

Location & Comments

CORNER SITS ON A 50% N.W. SLOPE

Compass Declination 19 1/2°

Firm/Agency LOWE ROCK TIMBER COMPANY

Address P.O. BOX 1127 ROSSBORO

Party Chief KEN HOFFINE

Notes

Witness GARY ANGIOLET

Surveyor's Seal

REGISTERED
PROFESSIONAL
LAND SURVEYOR

Ken W Hoffine
OREGON
JULY 16, 1987
KEN W. HOFFINE
2291