

FILED

DEC 17 1990

OREGON CORNER RESTORATION FORM

Section 27 Township 26S Range 8W

County DOUGLAS Date 7/90

COUNTY SURVEYOR
DOUGLAS COUNTY, ORE.

Corner Designation

NE 1/16



SECTION 27

Previous Renewals/Surveys, etc. _____


- Condition Report Only
- Not Found
- Renewed
- Unrecorded
- Surveyed In
- Referenced Out

Monument(s) & Accessories Found: (Condition and Source)

- ✓ CORNER IS A 1/2" IRON PIPE WITH PLASTIC CAP (LS 1032) IN GOOD CONDITION
- ✓ 28" DF BEARS N 24° E 2.4 FT (TO W. MIN. IN FACE) SCRIBING VISIBLE AND WRITTEN B. T. TAG.
- ✓ 41" DF STUMP BEARS N 45° W 9.6 FT TO MIDDLE OF STUMP, SCRIBING VISIBLE.

Monument Detail

Sketch

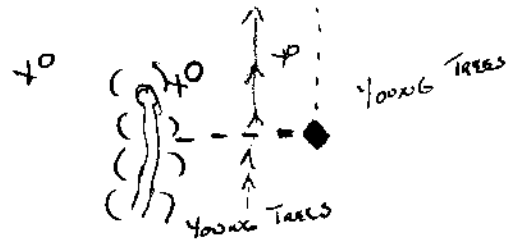

Monument Set (Procedures and Description)

New Accessories

- PAINTED FACES AND WROTE B.T. ON TREE TRUNKS OF B.T.'S WITH FLORE ORANGE PAINT.
- PUT UP LONG ROCK TIMBER LOCATION TAG ON 6" DF BEARING S 81° W 1.4 FT.

Location & Comments

CORNER LIES APPROX
100 FT EAST OF CREEK
WITH CLEAR CUT TO THE
NORTHWEST AND YOUNG
TREES TO THE EAST AND
SOUTH

Compass Declination 19 1/2°
Firm/Agency LONG ROCK
TIMBER COMPANY
Address P.O. BOX 1127
ROSS BURG
Party Chief KEN HOFFINE
Notes _____
Witness CARLY ANGIOLET

Surveyor's Seal

REGISTERED
PROFESSIONAL
LAND SURVEYOR

Ken W Hoffine

OREGON
JULY 18, 1987
KEN W. HOFFINE
2291