

FILED

JK

DEC 17 1990

OREGON CORNER RESTORATION FORM

Section 34 Township 26S Range 8W

County DOUGLAS Date 7/90

COUNTY SURVEYOR
DOUGLAS COUNTY, ORE.

Corner Designation

T26S R8W

S27 | S26

S34 | S35

- Condition Report Only
- Not Found
- Renewed
- Unrecorded
- Surveyed In
- Referenced Out


Previous Renewals/Surveys, etc. _____

Monument(s) & Accessories Found: (Condition and Source)

- CORNER IS A BRASS CAP IN GOOD CONDITION
- ✓ 12" D.F. BEARS N44°E 32.1 FT. GOOD SCAR AND B.T. TAG
- ✓ 10" D.F. SWAG D.F. BEARS N83°W 27.4 FT. SCRIBING VISIBLE AND B.T. TAG
- ✓ 13" D.F. BEARS S61°W 40.8 FT. WELL HEALED FACE AND B.T. TAG
- ✓ 10" D.F. BEARS S66°E 10.5 FT. GOOD SCAR AND 2 B.T. TAGS

Monument Detail

Sketch

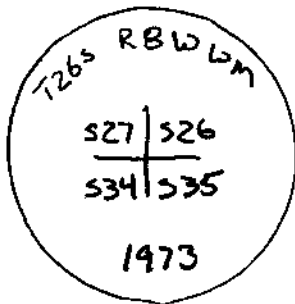

Monument Set (Procedures and Description)

New Accessories

PAINTED FACE AND WROTE B.T. ON TREE TRUNKS OF B.T.'S
 WITH FLOUR ORANGE PAINT

Location & Comments

CORNER LIES ON FLAT Compass Declination 19 1/2
 APPROX 175 FT NORTH Firm/Agency LOWE ROCK
 OF THE MAIN CALHAN'S TIMBER COMPANY
 RIDGE ROAD Address P.O. BOX 1127
ROSEBUD
 Party Chief KEN HOFFINE
 Notes _____
 Witness GARY ANGIOLET

Surveyor's Seal

