

FILED

*SL*

OREGON CORNER RESTORATION FORM

Section 36 Township 26S Range 8W

DEC 17 1990

County DOUGLAS Date 7/90

COUNTY SURVEYOR  
DOUGLAS COUNTY, ORE.

Corner Designation

CW 1/16



SECTION 36

Previous Renewals/Surveys, etc. \_\_\_\_\_

- Condition Report Only
- Not Found
- Renewed
- Unrecorded
- Surveyed In
- Referenced Out



Monument(s) & Accessories Found: (Condition and Source)

CORNER IS A BRASS CAP IN GOOD CONDITION  
 19" DF BEARS N11°W 13.8 FT WELL HEALED FACE, BLM & WYCO B.T. TAGS  
 14" DF HIGH STUMP BEARS S6°W 2.5 FT GOOD SCAR, BLM & WYCO B.T. TAGS

MAY-49

Monument Detail

Sketch

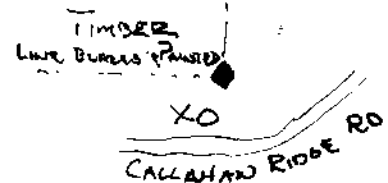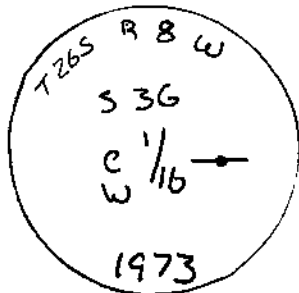

Monument Set (Procedures and Description)

New Accessories

PAINT FACES AND WRITE B.T. ON TREE TRUNKS OF B.T.'S IN FLOUR. ORANGE PAINT.

Location & Comments

CORNER LIES ON FLAT Compass Declination 19 1/2  
 RIDGE IN HEAVY SUSH Firm/Agency LONG ROCK  
 AND BRUSH AN OLD TIMBER COMPANY  
 GROWTH D.F. LOG JUST Address P.O. BOX 1127  
 TO THE EAST OF CORNER ROSERUEG

Surveyor's Seal

REGISTERED  
 PROFESSIONAL  
 LAND SURVEYOR

*Ken W Hoffine*  
 OREGON  
 JULY 18, 1987  
 KEN W. HOFFINE  
 2291

Party Chief Ken Hoffine

Notes \_\_\_\_\_

Witness GARY ANGLICET

C.S. File No. 63/127-33

X