

FILED

OREGON CORNER RESTORATION FORM

DEC 20 1990

Section 7 Township 225 Range 7 W

County DOUGLAS Date 11/17/90

COUNTY SURVEYOR
DOUGLAS COUNTY, ORE.

Corner Designation

CS 1/16 57

- Condition Report Only
- Not Found
- Renewed
- Unrecorded
- Surveyed In
- Referenced Out


Previous Renewals/Surveys, etc. _____

Monument(s) & Accessories Found: (Condition and Source)

FD: 3/4" BRASS CAP ON 2" O.D. IRON PIPE, SET IN A
STONE MOUND. A 28" D. FIR BRS. N41E 6.6' A
34" D. FIR BRS. S41W 20.5'

Monument Detail

Sketch

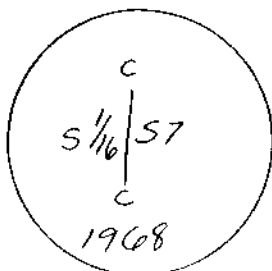

Monument Set (Procedures and Description)

REMOVED THE ABOVE BRASS CAP AS PER
BLM INSTRUCTIONS TO PREVENT
DAMAGE DURING LOGGING. THE BRASS
CAP WILL BE REPLACED AFTER LOGGING
OPERATIONS ARE FINISHED.


New Accessories

SET A 5/8 IRON ROD 30" LONG, BRS N87E 4.70'
BELOW GROUND.
SET A 5/8 IRON ROD 30" LONG, BRS. S13W 5.93'
BELOW GROUND.

Location & Comments

Surveyor's Seal

Compass Declination _____
 CORNER FALLS Firm/Agency STANTZNER
 ON ROCKY ENG.
 RIDGE Address P.O. BOX 118
 COOSBAY OR. 97422
 Party Chief J. ESTABROOK
 Notes _____
 Witness _____

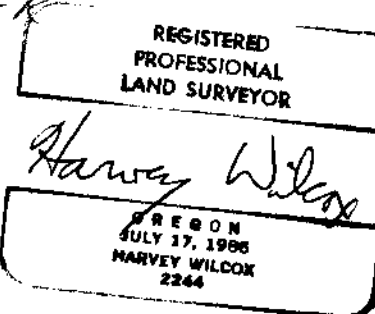

C.S. File No. 63/127-34