

OREGON CORNER RESTORATION FORM

Section: 14 Township: 32S Range: 6W

County: Douglas Date: 12/19/90

FILED

DEC 26 1990

COUNTY SURVEYOR  
DOUGLAS COUNTY, ORE.

Corner Designation

S 1/16 cor. of secs. 14 and 15

Previous Renewals/Surveys, etc.: Original Section Subdivision of 1881, Lorne Van Swearingen 1963, BLM Survey of 1966.

Monument(s) & Accessories Found:



Found: Dislodged iron post, 2 ins. diam., 28 ins. long with brass cap mkd.

S 1/16  
S 15 | S 14  
1966

Found: BLM B.T., 18.9" DBH DF, bears S45°E, 75 lks. dist., with healed blaze and scribed bearing tag.

Found: BLM B.T., 23.8" DBH DF, bears N78°W, 23 lks. dist., with healed blaze and scribed bearing tag.

Monument Detail:

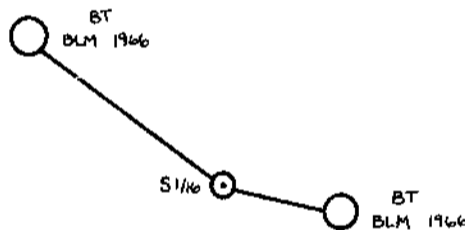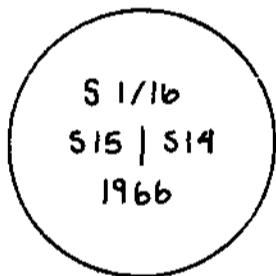

Monument Set:

Measured distance and bearing from BLM's 1966 18.9" fir (S45°E, 75 lks.). Measured distance and bearing from BLM's 1966 23.8" fir (N78°W, 23 lks.). Proceeded to dig to solid rock. Re-set 1966 BLM monument S45°E, 75 lks. from opened face of 18.9" DF, and N78°W, 23 lks. from opened face of 23.8" DF, 12 ins. in ground to solid rock, and in a mound of stone.

New Accessories:

N/A

Location and comments:

Corner lies on E facing slope approx. 100' E of road (32-6-15.1).

Compass Declination: 19°30'E.

Firm: Gregory Forest Products.

Address: P.O. Box C, Glendale, OR 97442.

Party Crew: Dave Krueger, Pat Fadden.

Surveyor's Seal



*Thomas H. Mehl III*

