

FILED

MAR 12 1991


OREGON CORNER RESTORATION FORM

Section _____ Township 31S Range 1W, W.M.

County Douglas Date March 5, '91

COUNTY SURVEYOR
DOUGLAS COUNTY, ORE.

Section
Corner Designation

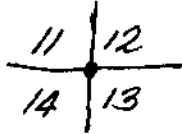

- Condition Report Only
- Not Found
- Renewed
- Unrecorded
- Surveyed In
- Referenced Out

Previous Renewals/Surveys, etc.

Douglas County Surveyor set new BT's in 1968
(Corner No. 94, T31S, R1W, W.M.)

Monument(s) & Accessories Found: (Condition and Source)

FOUND BT'S, all faces overgrown

16" D. Fir, S12°E, 12⁰ Feet

12" D. Fir, S68 1/2°W, 15³ Feet

14" D. Fir, N68°W, 12¹ Feet


16" D. Fir, N7°E, 31⁷ Feet

Monument Detail

Sketch

FOUND

2 1/2" Brass Cap set
on 2" Iron Pipe.

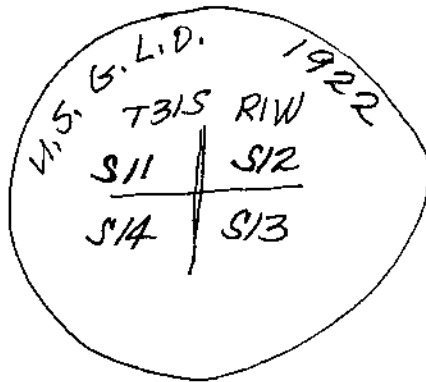

Monument Set (Procedures and Description)

None

New Accessories

None

Location & Comments

Corner lies about
400 Feet SW of
new Road to be
constructed (Road
No. 31DD-74D.)

Corner in good
shape.

Compass Declination 20 1/2° E

Firm/Agency Shaner Engineer-
ing, Inc.

Address P.O. Box 1430

Party Chief BRUCE SHANER

Notes " "

Witness JACK WRIGHT

Surveyor's Seal

REGISTERED
PROFESSIONAL
LAND SURVEYOR

Bruce A Shaner

OREGON
OCT. 4, 1987
BRUCE A. SHANER
430