

M 111-60

FILED

APR 8 1991

OREGON CORNER RESTORATION FORM

Section 26 Township 20S Range 7W

County Douglas Date 01-28-91

COUNTY SURVEYOR
DOUGLAS COUNTY, ORE.

CORNER DESIGNATION

North 1/4 Corner
Section 26

- Condition Report Only
- Not Found
- Renewed
- Unrecorded
- Surveyed In
- Referenced Out

Previous Renewals/Surveys, etc. Original G.L.O. Survey by Thomas E. Todd in 1891. 1989 B.L.M. survey by Roseburg B.L.M. (Un-approved)

Monument(s) & Accessories Found: (Condition and Source)


Found 1989 B.L.M. pipe and brass cap set firmly in the ground.

11" Fir, N60W, 48.1' (Scribe Vis.), 1989 BT. Record ?

15" Fir, S68W, 10.2' (Scribe Vis.), 1989 BT. Record ?

Monument Detail

Sketch

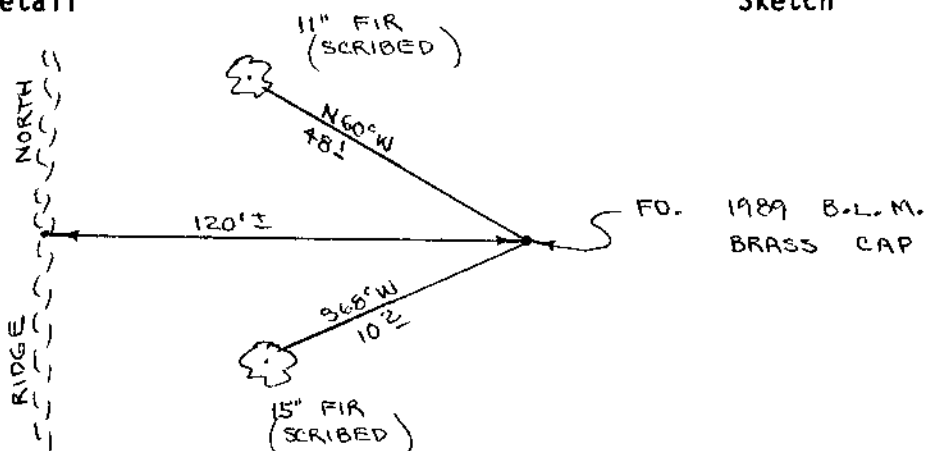

Monument Set (Procedures and Description)

New Accessories

Set 72" Aluminum post, with land monument survey sign bolted to, beside brass cap. Painted all bearing trees red.

Location & Comments

Corner lies on steep East slope about 120' East of ridge. Ridge bears North and South

Compass Declination 20 1/2
 Firm/Agency Roberts Surveying Inc.
 Address 29 West 29th St. Eugene, Oregon 97405
 Party Chief Ted Baker
 Notes _____
 Witness Harvey Christensen

Surveyor's Seal



M 111-60

FILED

APR 8 1991

OREGON CORNER RESTORATION FORM

Section 26 Township 20S Range 7W

County Douglas Date 01-25-91

COUNTY SURVEYOR
DOUGLAS COUNTY, ORE.

CORNER DESIGNATION

South 1/4 Corner
Section 26

- Condition Report Only
- Not Found
- Renewed
- Unrecorded
- Surveyed In
- Referenced Out

Previous Renewals/Surveys, etc. Original G.L.O. Survey by Thomas E. Todd in 1891. Douglas County Renewal #66 by Wilford Haines in 1967. A 1990 B.L.M. survey by Roseburg B.L.M. (Un-approved)

Monument(s) & Accessories Found: (Condition and Source)

Found 1990 B.L.M. pipe and brass cap set firmly in the ground. Did not find 5/8" iron rod set by Wilford Haines in 1967.


42" Cedar, S29W, 10.3' (Scribe Vis.), 1891 BT. Record S30W, 9.9'

54" Maple, N23W, 43.2' (Scar Vis.), 1967 BT. Record N22W, 42.4'

14" Maple, N72E, 44.2' (Scribe Vis.), 1990 BT. Record ?

Monument Detail

Sketch

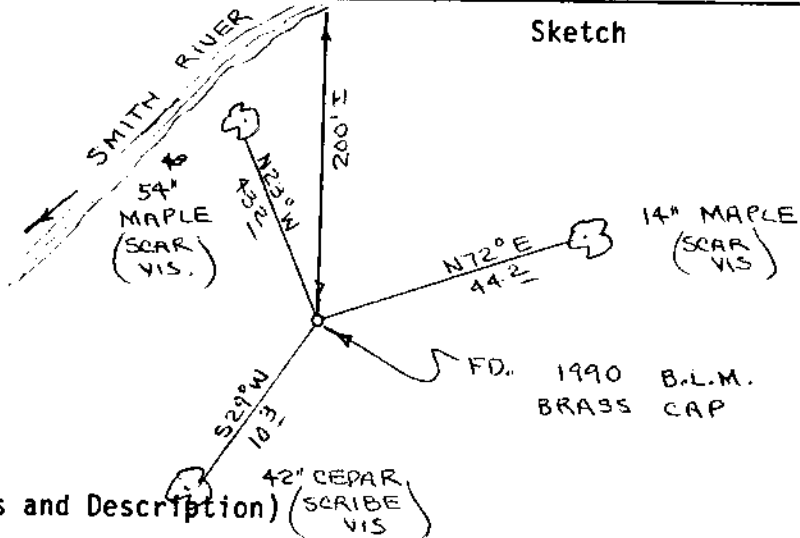

Monument Set (Procedures and Description)

New Accessories

Set 72" Aluminum post, with land monument survey sign bolted to, beside brass cap. Painted all bearing trees red.

Location & Comments

Corner lies on flat ground about 200 feet South of Smith River. Compass Declination 20 1/2
Firm/Agency Roberts Surveying Inc.
Address 29 West 29th St. Eugene, Oregon 97405
Party Chief Ted Baker
Notes
Witness Harvey Christensen

Surveyor's Seal

