


CERTIFIED RECORD OF LAND CORNER MONUMENTATION

History of original corner establishment:

GLENN BAUGHMAN, RLS 536, SUBDIVIDED SECTION 22, T32S, R3W, W.M, FOR THE USDA, FOREST SERVICE IN 1974

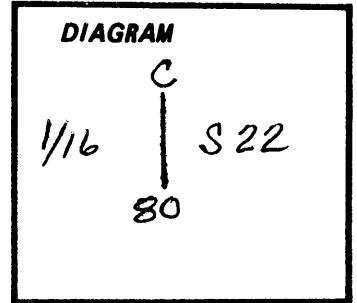

Description of corner evidence found:

2 1/2" IRON PIPE WITH 4" BRASS CAP 4" ABOVE GROUND IN MOUND OF STONE, MARKED

21" D. FIR BEARS S39°E, 13.9 FT WITH HEALED BLAZE

9" D. FIR (SNAG) BEARS S16°W, 16.8 FT WITH HEALED BLAZE

C

1/16 | S 22

80

RLS 536

1974

Description of monument and accessories I established to perpetuate the original location of this corner:

12" HEMLOCK BEARS N78°W, 34.7 FT I SCRIBED

" C 80 1/16 BT" WITH ALUMINUM TAG MARKED

" ARTMAN RLS 2268" NAILED FLUSH TO BT FACE

FILED JP

SEP 5 1991

COUNTY SURVEYOR  
DOUGLAS COUNTY, ORE.

REGISTERED  
PROFESSIONAL  
LAND SURVEYOR

*J.P. Artman*

OREGON  
JULY 16, 1987  
JAMES O. ARTMAN

8/9/91

Office of.....County..Surveyor..... County of.....Douglas.....

State of.....Oregon....., I hereby certify that the within instrument was filed in this office

for record on the.....5... day of.....September....., 19.91.

Fritz Ingram..Douglas..County..Surveyor..... by *Virginia C. Saugers*.....

(COUNTY OFFICIAL)

(DEPUTY)