

FILED JP

GEODETIC CONTROL SURVEY REPORT  
for CITY OF ROSEBURG

MAY 21 1992

Section 22, T27S, R6W  
February 1992

COUNTY SURVEYOR  
DOUGLAS COUNTY, ORE.

Survey by: AA Surveying Service, Inc. 2566 N.  
Stephens Street Roseburg, Oregon 97470

Purpose: To replace a monument destroyed during  
street construction.

Personnel: Mark Heimbürger, David Collier,  
Jeremy Pieske, Darrell Jones

Equipment: Lietz Total Station Model "Set 3" and Data  
Recorder Model "SDR 33".

Precision: FGCC Order C-3, Class I

All vertical control elevations held are from the 1947 adjustment of  
NAVD on record in the Douglas County Surveyor's office QUAD Books.

All horizontal control station positions held are from the DCSO 1927  
record in the Douglas County Surveyor's office QUAD books. All control  
positions established have been adjusted using those control stations.

**HORIZONTAL CONTROL HELD**


<u>Point No.</u>	<u>Station Name</u>	<u>Monument Type</u>	<u>Monument Markings</u>	<u>Locations</u>
1	"SH-1B" N. 576,383.45 E-1,229,882.80	3/4" IP St. Mon.w/cover	None	T27S,R6W,NE1/4 S22
2	"SH-2B" N. 576,567.67 E1,229,358.31	BC St. Mon. w/cover	None	T27S,R6W,NE1/4 S22



*Mark A. Heimbürger*



OFFICE OF THE  
DOUGLAS COUNTY SURVEYOR

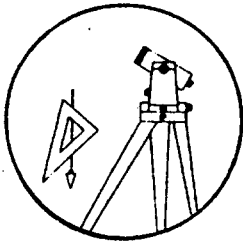

Station: RM SH-22

T 27 S R 6 W S 22


Date set: DEC. 1991

Set By (Agency): AA SURVEYING

Date Recovered: \_\_\_\_\_

Recovered By: \_\_\_\_\_

- Found
- New
- Reset
- Not Found
- Referenced
- Destroyed

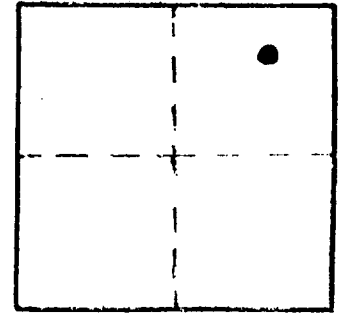

VERTICAL CONTROL

Elevation: \_\_\_\_\_ NGS Line # \_\_\_\_\_ USGS Line # \_\_\_\_\_ OSHD Line # \_\_\_\_\_

Precision: \_\_\_\_\_ Agency: \_\_\_\_\_ Proj. # \_\_\_\_\_ Date: \_\_\_\_\_

HORIZONTAL CONTROL

South Zone State Plane Coordinates: Y(Northing) 576319.21 X(Easting) 1229260.98

Precision: 1/10000 Agency: \_\_\_\_\_ Proj. # \_\_\_\_\_ Date: \_\_\_\_\_

Approximate Geographic Position: Latitude \_\_\_\_\_ Longitude \_\_\_\_\_

DESCRIPTION and TO REACH

TO REACH: GO TO INTERSECTION OF W. HICKORY ST. AND  
W. NORMANDY ST.

**FILED** *JP*

**MAY 21 1992**

**COUNTY SURVEYOR  
DOUGLAS COUNTY, ORE.**

Reference Marks:

A 2" IRON PIPE WITH 1-1/2" BRASS DISK STAMPED: "RM SH 22"  
SET BELOW THE PAVEMENT IN A MONUMENT BOX.  
INVERSE FROM "SH-22" TO "RM SH-22" = S 23° 11' 55" W 0.03 FEET.

