

M114-29

FILED

JA

OREGON CORNER RESTORATION FORM

JAN 15 1992

Section 22 Township 20S Range 11W

COUNTY SURVEYOR
DOUGLAS COUNTY, ORE.

County Douglas Date 05-22-91

CORNER DESIGNATION

S.W. Corner
Section 22


- Condition Report Only
- Not Found
- Renewed
- Unrecorded
- Surveyed In
- Referenced Out

Previous Renewals/Surveys, etc. Original G.L.O. Survey by William Thiel in 1891-1892. Survey M91-55 by Ronald Stuntzner dated October-November 1981.

Monument(s) & Accessories Found: (Condition and Source)

- Found 1981 Aluminum Pipe and Cap as set in Survey M91-55
- 28" Fir Stump, N72E, 16.6' (No Marks), 1891 BT. Rec. N65E, 16.5'
- 22" Downed Cedar, S26E, 26.0' (No Marks), 1891 BT. Rec. S68 1/2 E, 20.5'
- 26" ^{HEM.} Fir Stub, S45W, 18.8' (No Marks), 1891 BT. Rec. S53W, 15.2'
- 30" Hemlock Stub, N54W, 13.4' (No Marks), 1891 BT. Rec. N53W, 9.2'
- 10" Fir, N37W, 8.4' (Scar Vis.), 1981 BT. Rec. N38W, 8.7'
- 12" Fir, S27W, 3.1' (Scar Vis.), 1981 BT. Rec. S27 1/2 W, 3.3'
- 13" Fir, N33E, 11.3' (Scar Vis.), 1981 BT. Rec. N32E, 11.4'
- 13" Fir, S54E, 24.3' (Scribe Vis.), 1981 BT. Rec. S55E, 24.3'

Monument Detail

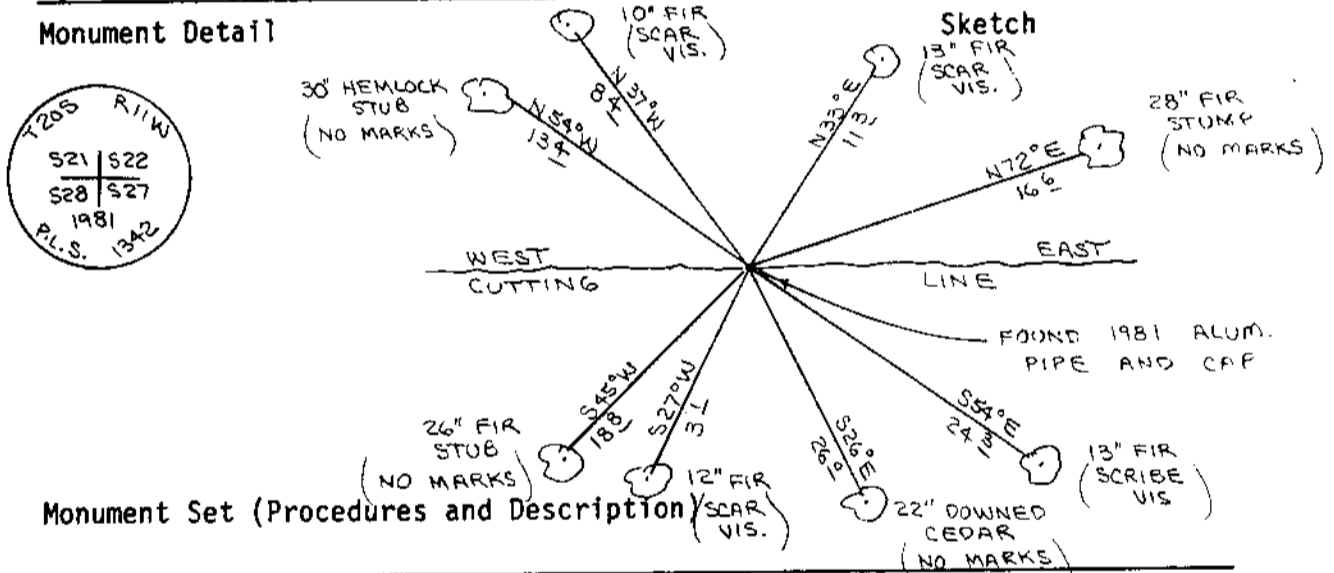

Monument Set (Procedures and Description)


New Accessories

Painted all bearing trees red.

Location & Comments

Corner lies on West slope Compass Declination 19°
 at South edge of clear cut Firm/Agency Roberts
unit. Cutting line runs Surveying Inc.
East-West Address 29 West 29th St.
Eugene, Oregon 97405
 Party Chief Ted Baker
 Notes _____
 Witness Harvey Christensen

Surveyor's Seal

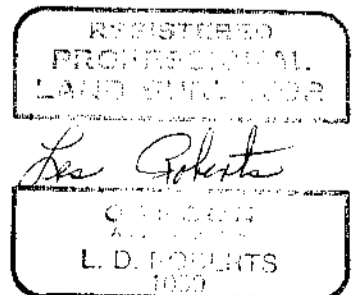

C.S. File No. 63/138-2A

M 114-29

FILED

Handwritten mark

OREGON CORNER RESTORATION FORM

Section 22 Township 20S Range 11W

JAN 15 1992

County Douglas Date 05-22-91

COUNTY SURVEYOR
DOUGLAS COUNTY, ORE.

CORNER DESIGNATION

South 1/4 Corner
Section 22

- Condition Report Only
- Not Found
- Renewed
- Unrecorded
- Surveyed In
- Referenced Out

Previous Renewals/Surveys, etc. Original G.L.O. Survey by William Thiel in 1891-1892. Survey M91-55 by Ronald Stuntzner dated October-November 1981.

Monument(s) & Accessories Found: (Condition and Source)


Found 1981 Aluminum Pipe and Cap as set in Survey M91-55.

14" Fir, N52E, 33.6' (Scar Vis.), 1981 BT. Record N51E, 33.9'

15" Alder, S73W, 24.7' (Bark Scribed), 1981 BT. Record S72W, 24.0'

46" Fir Snag, S21E, 25.9' (Scribe Vis.), 1981 BT. Record S23E, 25.4'

Monument Detail

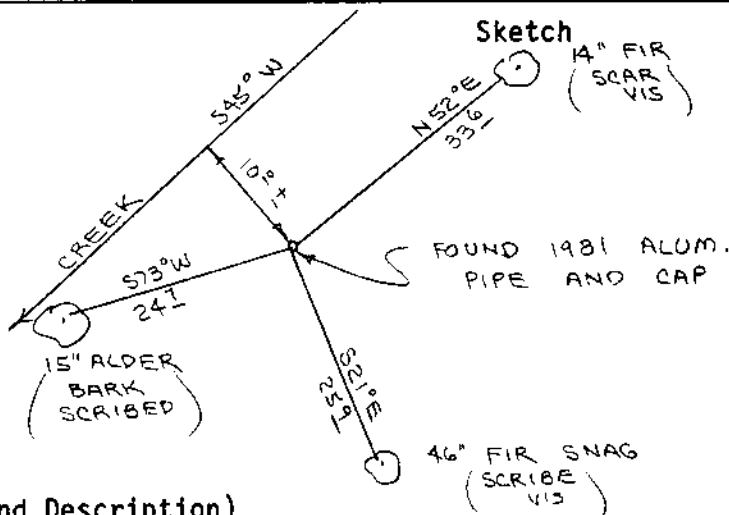

Monument Set (Procedures and Description)

New Accessories

Painted all bearing trees red.

Location & Comments

Corner lies on West slope Compass Declination 19°

on South edge of creek. Firm/Agency Roberts

Creek bears S45W. Surveying, Inc.

Address 29 West 29th St.


Eugene, Oregon 97405

Party Chief Ted Baker

Notes

Witness Harvey Christensen

Surveyor's Seal

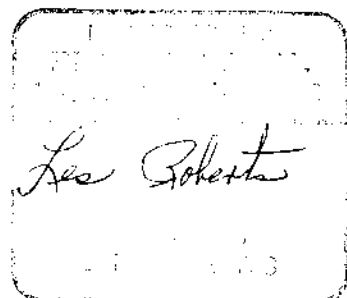

M 114-29

FILED

vr

JAN 15 1992

OREGON CORNER RESTORATION FORM

Section 22 Township 20S Range 11W

COUNTY SURVEYOR
DOUGLAS COUNTY, ORE.

County Douglas Date 06-28-91

CORNER DESIGNATION

Witness Corner to Line Tree
West Line Section 22.


- Condition Report Only
- Not Found
- Renewed
- Unrecorded
- Surveyed In
- Referenced Out

Previous Renewals/Surveys, etc. Original G.L.O. Survey by William Thiel
in 1891-1892. Survey M91-55 by Ronald Stuntzner dated October-November
1981.

Monument(s) & Accessories Found: (Condition and Source)

Found 1981 Aluminum Pipe and Cap set in Survey M91-55. 50" Line Tree
Stump bears N 0°06'43" E, 12.00'
16" Hemlock, S42W, 25.7' (Scribe Vis.), 1981 BT. Record S41W, 25.8'
24" Hemlock, N12W, 50.4' (Scribe Vis.), 1981 BT. Record N13W, 51.3'

Monument Detail

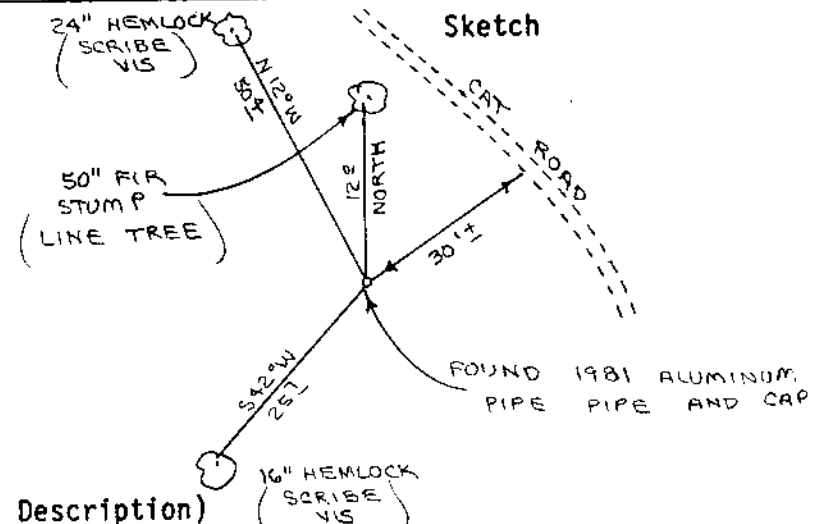

Monument Set (Procedures and Description)


New Accessories

Painted all bearing trees red.

Location & Comments

Corner lies on S.W. slope about 30 feet West of cat road. Cat road bears NW and SE.
Compass Declination 19°
Firm/Agency Roberts Surveying Inc.
Address 29 West 29th ST. Eugene, Oregon 97405
Party Chief Ted Baker
Notes
Witness Rick Jones

Surveyor's Seal

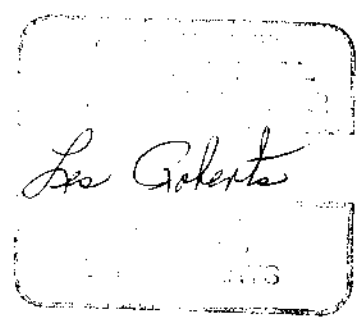

C.S. File No. 63/138-2C

M114-29

FILED

OR

JAN 15 1992

OREGON CORNER RESTORATION FORM

Section 22 Township 20S Range 11W

County Douglas Date 06-27-91

COUNTY SURVEYOR
DOUGLAS COUNTY, ORE.

CORNER DESIGNATION

West 1/4 Corner
Section 22.

- Condition Report Only
- Not Found
- Renewed
- Unrecorded
- Surveyed In
- Referenced Out

Previous Renewals/Surveys, etc. Original G.L.O. Survey by William Thiel in 1891-1892. Corner renewal field notes C.S. 53/66.

Monument(s) & Accessories Found: (Condition and Source)


Found 1964 Douglas County Brass cap lying on the ground. Reset brass cap from 1964 Douglas County bearing trees.

10" Hemlock Snag, S85E, 76.0' (Scribe Vis.), 1960 BT. Record S85E, 76.0

14" Hemlock Snag, S16W, 46.8' (Scribe Vis.), 1960 BT. Record S16W, 46.8'

Monument Detail

Sketch

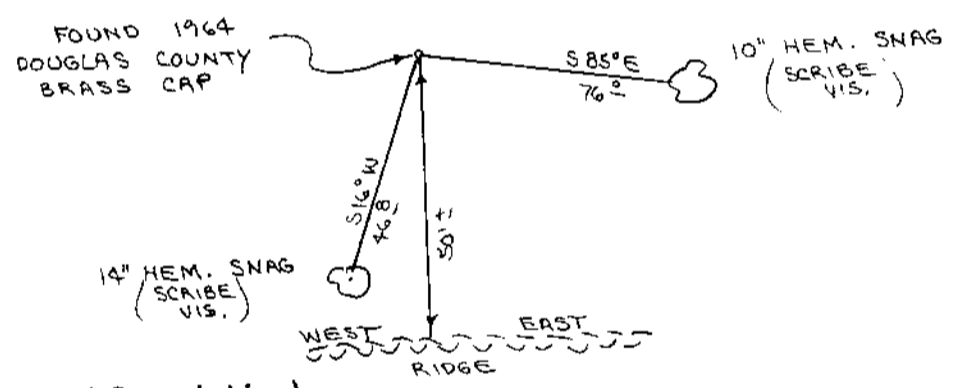

Monument Set (Procedures and Description)

New Accessories

7" Hemlock, N63E, 29.1' (Scribed 1/4 S22 BT), Painted Red

10" Fir, N76W, 36.6' (Scribed 1/4 S21 BT), Painted Red

Painted all bearing trees red and set a 72" aluminum post, with a land survey sign attached to, beside brass cap.

Location & Comments

Corner lies on steep North slope about 50 feet North of East-West ridge.

Compass Declination 19°

Firm/Agency Roberts Surveying Inc.


Address 29 West 29th St. Eugene, Oregon 97405

Party Chief Ted Baker

Notes

Witness Rick Jones

Surveyor's Seal

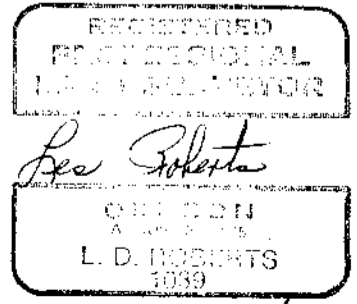

C.S. File No. 63/128-2

M114-29

FILED

JAN 15 1992

OREGON CORNER RESTORATION FORM

Section 22 Township 20S Range 11W

County Douglas Date 07-15-91

COUNTY SURVEYOR
DOUGLAS COUNTY, ORE.

CORNER DESIGNATION

S.W. 1/16 Corner
Section 22


- Condition Report Only
- Not Found
- Renewed
- Unrecorded
- Surveyed In
- Referenced Out

Previous Renewals/Surveys, etc. No previous surveys or renewals

Monument(s) & Accessories Found: (Condition and Source)

None

Monument Detail

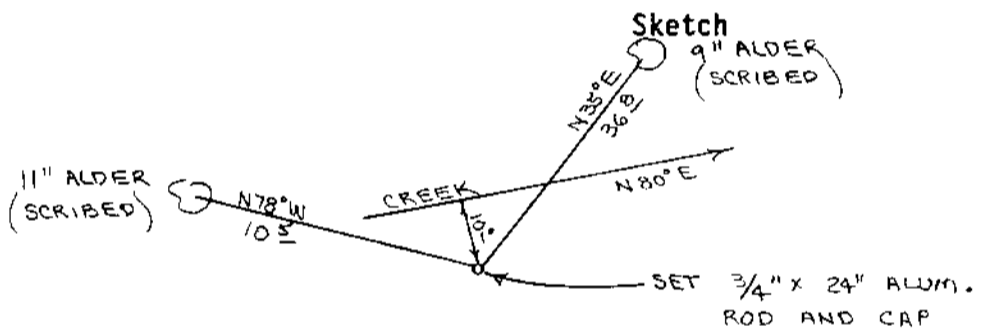

Monument Set (Procedures and Description)

Set 3/4" x 24" aluminum rod with a 3/8" aluminum cap. Buried purple magnetic marker under 24" aluminum rod. See filed survey for surveying procedures.

New Accessories

9" Alder, N35E, 36.8', Bark Scribed "SW1/16 S22 BT", Painted red.

11" Alder, N78W, 10.5', Bark Scribed "SW1/16 S22 BT", Painted red.

Set a 72" aluminum post, with a land survey monument sign attached to, beside aluminum rod.

Location & Comments

Corner lies on South edge of small creek. Creek bears N80E. Compass Declination 19°

Firm/Agency Roberts Surveying Inc.


Address 29 West 29th St. Eugene, Oregon 97405

Party Chief Ted Baker

Notes

Witness Rick Jones

Surveyor's Seal

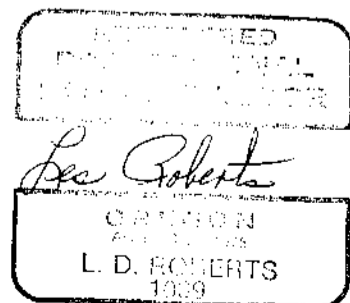

C.S. File No. 63/138-2

M 114-29

FILED

JK

OREGON CORNER RESTORATION FORM

JAN 15 1992

Section 22 Township 20S Range 11W

COUNTY SURVEYOR
DOUGLAS COUNTY, ORE.

County Douglas Date 07-15-91

CORNER DESIGNATION

C.S. 1/16 Corner
Section 22

- Condition Report Only
- Not Found
- Renewed
- Unrecorded
- Surveyed In
- Referenced Out


Previous Renewals/Surveys, etc. No previous surveys or renewals

Monument(s) & Accessories Found: (Condition and Source)

None

Monument Detail

Sketch

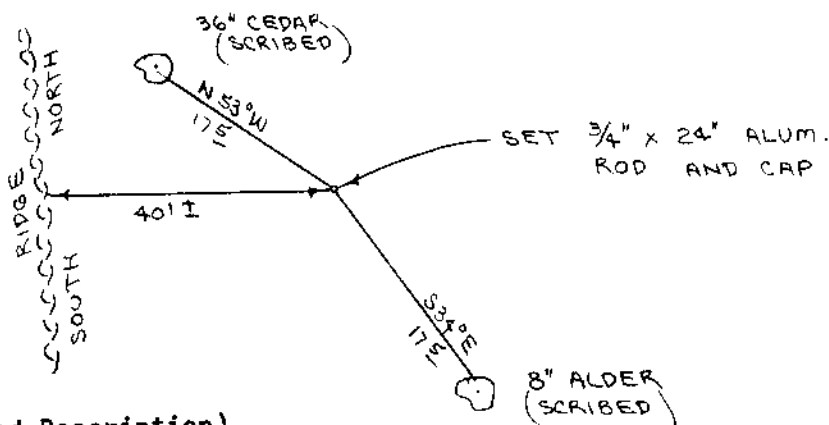

Monument Set (Procedures and Description)

Set 3/4" x 24" aluminum rod with a 3/4" aluminum cap. Buried purple magnetic marker under 24" aluminum rod. See filed survey for surveying procedures.


New Accessories

8" Alder, S34E, 17.5'. Bark Scribed "CS1/16 S22 BT", Painted red.
36" Cedar, N53W, 17.0', Scribed "CS1/16 S22 BT". Painted red.
Set a 72" aluminum post, with a land survey monument sign attached to, beside aluminum rod.

Location & Comments

Corner lies on East slope Compass Declination 19°
about 40 feet East of ridge. Firm/Agency Roberts
Ridge bears North-South. Surveying Inc.
Address 29 West 29th St.
Eugene, Oregon 97405
Party Chief Ted Baker
Notes
Witness Rick Jones

Surveyor's Seal

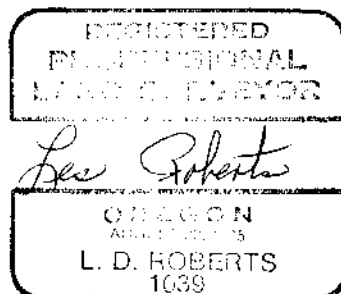

C.S. File No. 63/139-2
F

M114-29

FILED

28

JAN 15 1992

OREGON CORNER RESTORATION FORM

Section 22 Township 20S Range 11W

COUNTY SURVEYOR
DOUGLAS COUNTY, ORE.

County Douglas Date 07-16-91

CORNER DESIGNATION

Center 1/4 Corner
Section 22


- Condition Report Only
- Not Found
- Renewed
- Unrecorded
- Surveyed In
- Referenced Out

Previous Renewals/Surveys, etc. No previous surveys or renewals

Monument(s) & Accessories Found: (Condition and Source)

None

Monument Detail

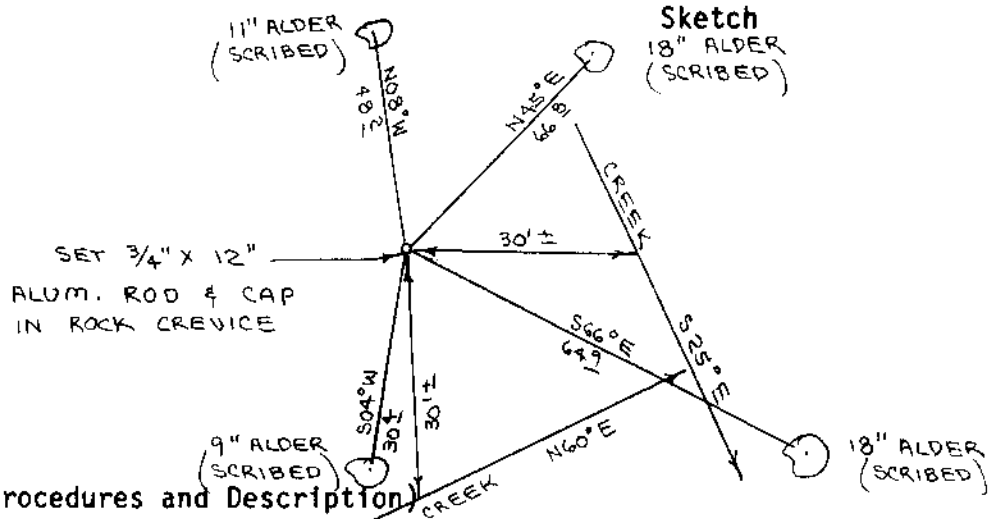

Monument Set (Procedures and Description)

Set 3/4" x 12" aluminum rod with a 3/8" aluminum cap. Buried purple magnetic marker under 12" Aluminum rod. See filed survey for surveying procedures.


New Accessories

- 9" Alder, S04W, 30.4', Bark Scribed "C1/4 S22 BT", Painted red.
- 11" Alder, N08W, 48.2', Bark Scribed "C1/4 S22 BT", Painted red.
- 18" Alder, N45E, 66.8', Bark Scribed "C1/4 S22 BT", Painted red.
- 18" Alder, S66E, 64.9', Bark Scribed "C1/4 S22 BT", Painted red.
- Set a 72" aluminum post, with a land survey monument sign attached to, beside aluminum rod.

Location & Comments

Corner lies on East slope and Westerly of 2 small creeks. Compass Declination 19°
Firm/Agency Roberts Surveying Inc.
Address 29 West 29th St. Eugene, Oregon 97405
Party Chief Ted Baker
Notes
Witness Rick Jones

Surveyor's Seal

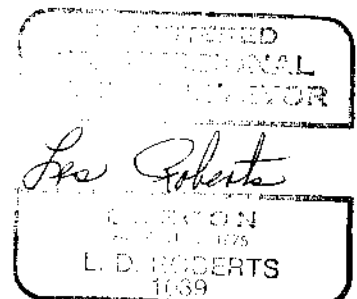

C.S. File No. 63/138-2

M114-29

FILED

JK

JAN 15 1992

OREGON CORNER RESTORATION FORM

Section 22 Township 20S Range 11W

COUNTY SURVEYOR
DOUGLAS COUNTY, ORE.

County Douglas Date 07-16-91

CORNER DESIGNATION

C.E. 1/16 Corner
Section 22.


- Condition Report Only
- Not Found
- Renewed
- Unrecorded
- Surveyed In
- Referenced Out

Previous Renewals/Surveys, etc. No previous surveys or renewals

Monument(s) & Accessories Found: (Condition and Source)

None

Monument Detail

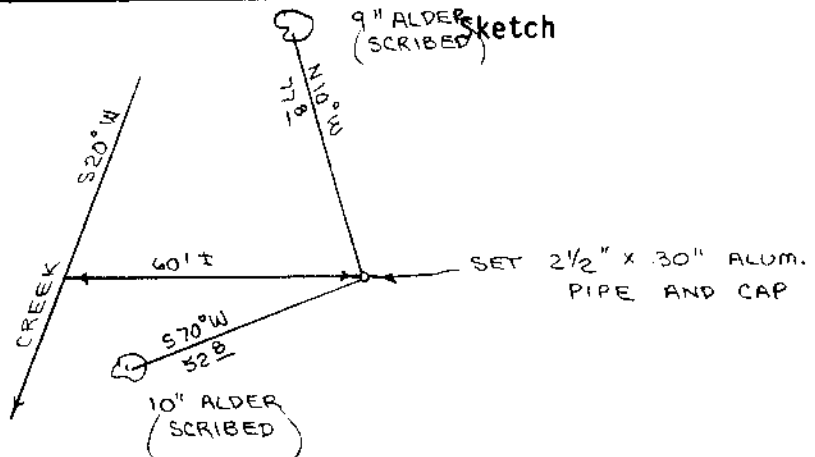

Monument Set (Procedures and Description)

Set 2 1/2" x 30" U.S. Forest Service Aluminum Pipe and Cap. Buried purple magnetic marker under 30" aluminum pipe. See filed survey for surveying procedures.

New Accessories

9" Alder, N10W, 77.8', Bark Scribed "CE1/16 S22 BT", Painted red.


10" Alder, S70W, 52.8', Bark Scribed "CE1/16 S22 BT", Painted red.

Set a 72" aluminum post, with a land survey monument sign attached to, beside aluminum pipe.

Location & Comments

Corner lies on a N.W. slope Compass Declination 19°
 about 60 feet East of a Firm/Agency Roberts
 small creek. Creek bears Surveying Inc.
S20W. Address 29 West 29th St.
Eugene, Oregon 97405
Party Chief Ted Baker
Notes
Witness Rick Jones

Surveyor's Seal

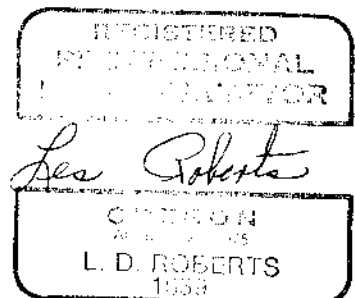

O.S. File No. 63/38-2H

M 114-29

FILED

JH

JAN 15 1992

OREGON CORNER RESTORATION FORM

Section 22 Township 20S Range 11W

COUNTY SURVEYOR
DOUGLAS COUNTY, ORE.

County Douglas Date 6-27-91

CORNER DESIGNATION

North $\frac{1}{4}$ Corner
Section 22

- Condition Report Only
- Not Found
- Renewed
- Unrecorded
- Surveyed In
- Referenced Out

Previous Renewals/Surveys, etc. Original C.L.O. Survey by William Thiel
in 1891-1892. Survey M73-7 by Ronald Stuntzner dated August 28, 1978.

Monument(s) & Accessories Found: (Condition and Source)

Found 1978 Brass Cap set in sandstone as noted in survey M73-7.

15" Alder, S01W, 37.2' (Bark Scribed), 1978 B.T. Rec. S02W, 37.67'


36" Fir, N82E, 67.0' (Scar Vis.), 1978 B.T. Rec. N84E, 67.22'

36" Fir Stump, S37E, 31.2' (Scar Vis.), 1978 B.T. Rec. S37E, 31.95'

48" Fir Snag N01W, 12.0' (No Marks), 1978 B.T. Rec. North, 12.2'

Monument Detail

Sketch

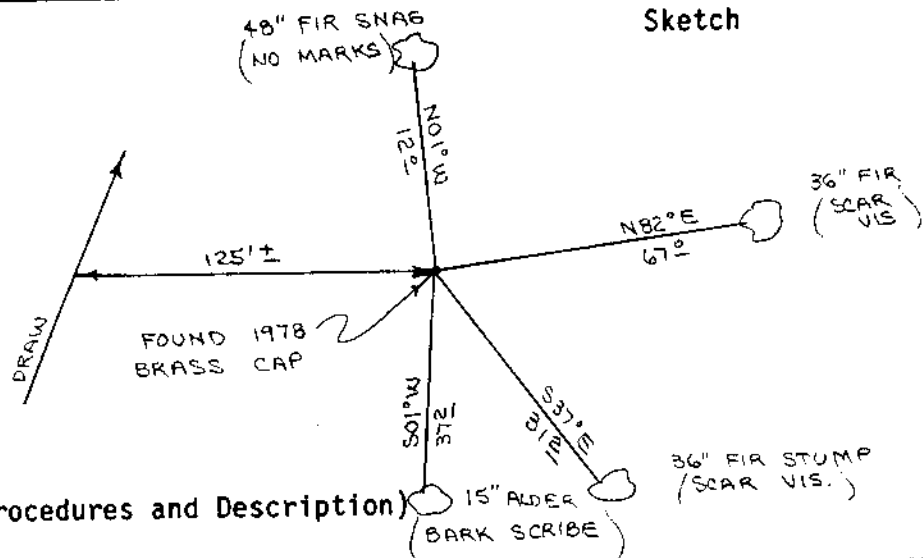

Monument Set (Procedures and Description)


New Accessories

Painted all bearing trees red.

Location & Comments

Corner lies on North slope Compass Declination 19°
 about 125' East of draw. Firm/Agency Roberts
Surveying Inc.
Address 29 West 29th St.
Eugene, Oregon 97405
Party Chief Ted Baker
Notes
Witness Rick Jones

Surveyor's Seal

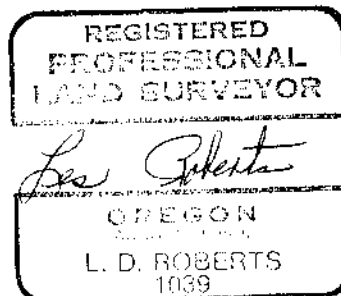

C.S. File No. 63/138-2
I

M114-29

FILED

JR

JAN 15 1992

OREGON CORNER RESTORATION FORM

Section 22 Township 20S Range 11W

COUNTY SURVEYOR
DOUGLAS COUNTY, ORE.

County Douglas Date 05-30-91

CORNER DESIGNATION

East 1/16 corner
North line Section 22

- Condition Report Only
- Not Found
- Renewed
- Unrecorded
- Surveyed In
- Referenced Out


Previous Renewals/Surveys, etc. Original G.L.O. Survey by William Thiel
in 1891-1892. Survey M73-7 by Ronald Stuntzner dated August 8, 1978.

Monument(s) & Accessories Found: (Condition and Source)

Found 1978 Brass Cap as set in survey M73-7.
11" Alder, S31W, 13.3' (Bark Scribed), 1978 B.T. Record S28W, 13.0'
15" Fir, S64E, 109.0' (Scar Vis.), 1978 B.T. Record S64E, 109.26'

Monument Detail

Sketch

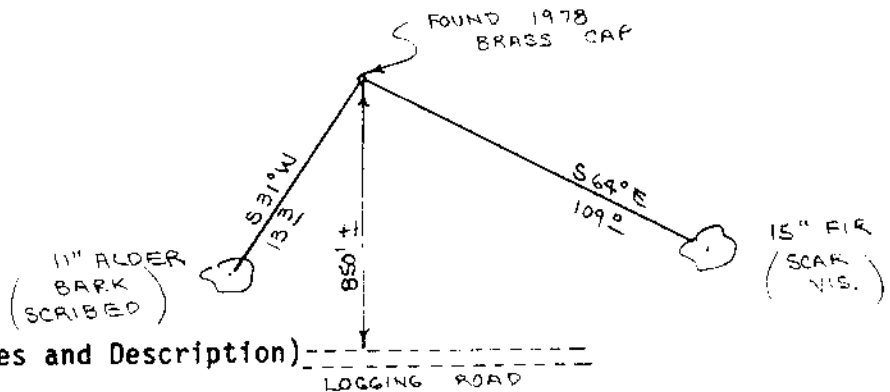

Monument Set (Procedures and Description)

New Accessories

Painted all bearing trees red.

Location & Comments

Corner lies on N.E. slope about 850 feet north of road Compass Declination 19°
Firm/Agency Roberts

Surveying Inc.

Address 29 West 29th ST.


Eugene, Oregon 97504

Party Chief Ted Baker

Notes

Witness Harvey Christensen

Surveyor's Seal

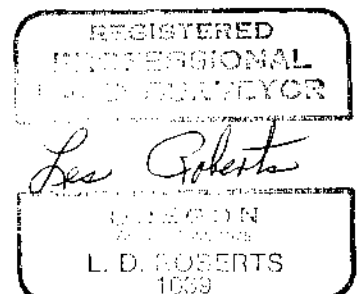

C.S. File No. 63/138-2
J

FILED

JH

JAN 15 1992

M114-29

OREGON CORNER RESTORATION FORM

COUNTY SURVEYOR
DOUGLAS COUNTY, ORE.

Section 22 Township 20S Range 11W

County Douglas Date 07-11-91

CORNER DESIGNATION

East 1/4 Corner
Section 22

- Condition Report Only
- Not Found
- Renewed
- Unrecorded
- Surveyed In
- Referenced Out

Previous Renewals/Surveys, etc. Original G.L.O. Survey by William Thiel
in 1891-1892. Survey M89-58 by Robert Ward dated May-September 1981.


Monument(s) & Accessories Found: (Condition and Source)

Found 1981 Aluminum Pipe and Cap as set in survey M89-58.

22" Hemlock, N52E, 33.2' (Scribe Vis.), 1981 BT. Record N52E, 33.1'

22" Hemlock, N62W, 30.8' (Scar Vis.), 1981 BT. Record N62W, 29.0'

Monument Detail

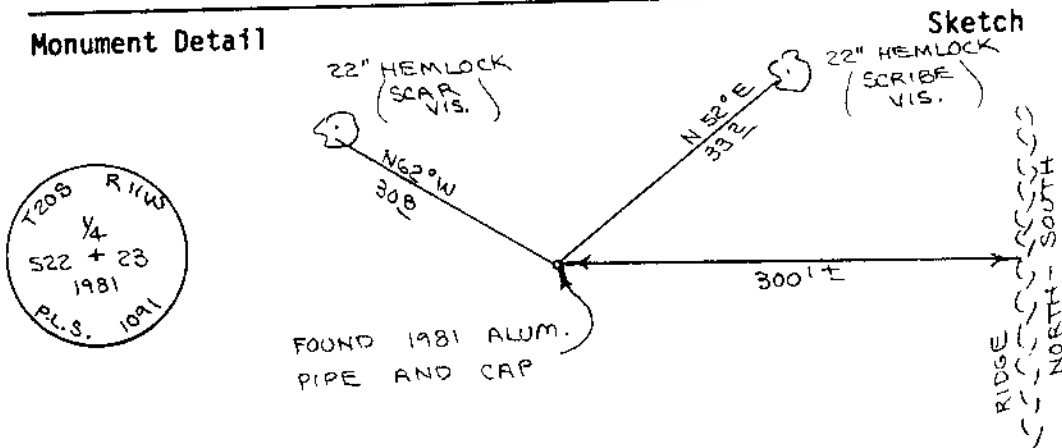

Monument Set (Procedures and Description)

New Accessories

Painted all bearing trees red.

Location & Comments

Corner lies on S.W. slope Compass Declination 19°

about 300' West of ridge. Firm/Agency Roberts

Ridge bears North-South. Surveying Inc.

Address 29 West 29th St.


Eugene, Oregon 97405

Party Chief Ted Baker

Notes

Witness Rick Jones

Surveyor's Seal

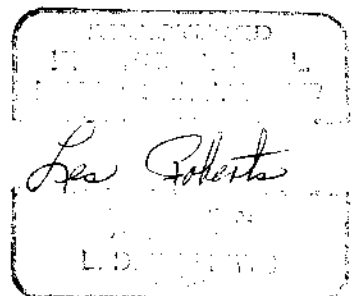

C.S. File No. 63/138-2
K

M114-29

FILED

JAN 15 1992

OREGON CORNER RESTORATION FORM

Section 22 Township 20S Range 11W

County Douglas Date 07-01-91

COUNTY SURVEYOR
DOUGLAS COUNTY, ORE,

CORNER DESIGNATION

West 1/16 Corner
South Line Section 22.


- Condition Report Only
- Not Found
- Renewed
- Unrecorded
- Surveyed In
- Referenced Out

Previous Renewals/Surveys, etc. Original G.L.O. Survey by William Thiel in 1891-1892. Survey M91-55 by Ronald Stuntzner dated October-November 1981.

Monument(s) & Accessories Found: (Condition and Source)

Found 1981 Aluminum Pipe and Cap as set in Survey M91-55.
12" Hemlock, S25E, 35.0' (Scar Vis.), 1981 BT. Record S25E, 35.2'
15" Hemlock, North, 53.4'(Scar Vis.), 1981 BT. Record N01W, 53.6'

Monument Detail

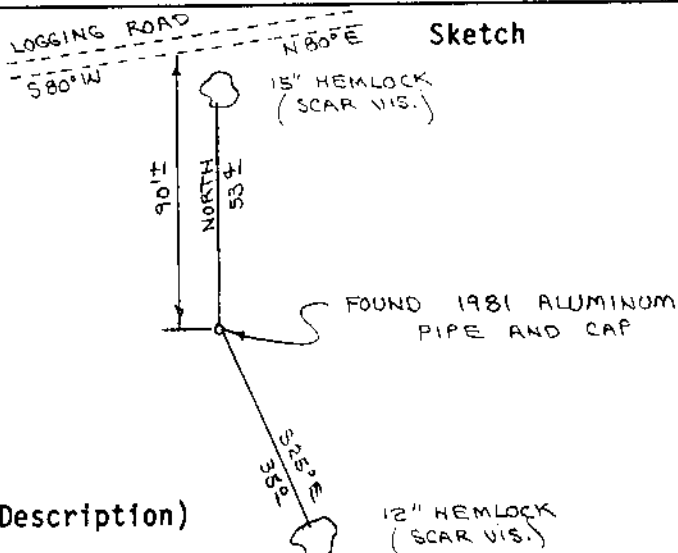

Monument Set (Procedures and Description)


New Accessories

Painted all bearing trees red

Location & Comments

Corner lies on North slope Compass Declination 19°
about 90 feet South of Firm/Agency Roberts
road. Road bears N80E and Surveying Inc.
S80W. Address 29 West 29th St.
Eugene, Oregon 97405
Party Chief Ted Baker
Notes
Witness Rick Jones

Surveyor's Seal

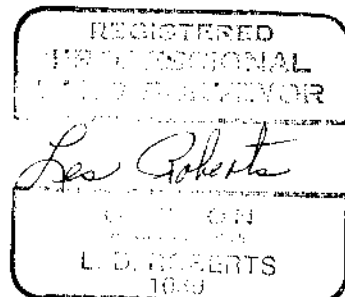

C.S. File No. 63/38-2