

FILED

*sh*

MAR 10 1992


CERTIFIED RECORD OF LAND CORNER MONUMENTATION

COUNTY SURVEYOR  
DOUGLAS COUNTY, ORE.

0-18

History of original corner establishment: This corner was originally established by Romano E. Ware, PLS 1005, and Ronald A. Quimby, PLS 1654, in 1980 as recorded in M79-44 as follows:

Set 2 1/2" iron pipe with brass cap marked "T27S R2W NW 1/16 S23 RLS 1654 1980"

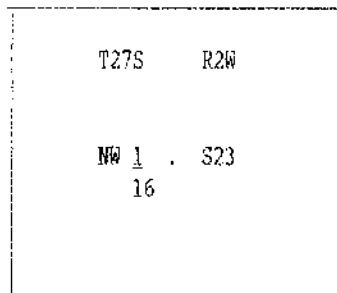

Scribed new BT's:

6" D. fir S. 4° W., 31.4' "NW 1/16 S 23 BT"

8" D. fir S. 33° W., 48.0' "NW 1/16 S 23 BT"

Description of corner evidence found:

A 2" iron pipe, firmly set, flush with the top of a 6" high x 18" diam. mound of stone and with a 2 1/2" brass cap marked:

T 27S R2W  
NW 1/16 S23  
16  
RLS 1654  
1980

from which bearing trees by Quimby & Ware in 1980:

A 11" D. fir bears S. 1 1/2° W., 31.2 ft. with a healed blaze. (Rec. S. 4° W., 31.4 ft.)

A 13" D. fir bears S. 41 1/2° W., 47.8 ft. with a healed blaze. (Rec. S. 33° W., 48.0 ft.)

Description of monument and accessories established to perpetuate the original location of this corner:

All bearing trees have a 6" red band painted around the tree and the blazed face painted red. U.S.F.S. sign 54-3, BEARING TREE, and sign 54-9, LAND SURVEYING MONUMENT, are nailed to all bearing trees. All new bearing trees have double blazed faces with a brass washer stamped "PLS 1941" nailed into the lower blaze. Bearings are taken to the center of the tree at the root crown, and distances are measured to the root crown at the side and center of the tree. Bearings and Distances were measured with a staff compass and steel tape.

The magnetic declination 16 1/2° E. was adjusted to match M79-44 bearings on posted boundary lines.

Witnesses: M. Promdahl, S. Brazil.

Office of Surveyor County of Douglas

State of Oregon, I hereby certify that the within instrument was filed in this office

for record on the 10th day of March, 19 92 at 12:30 clock P. M., (signed)

Fritz Ingram  
(COUNTY OFFICIAL)

by *Virginia A. Langer*  
(DEPUTY)

I hereby certify that the above corner was perpetuated as hereon described on December 20, 1991.

REGISTERED  
PROFESSIONAL  
LAND SURVEYOR

*Kristian O. DeGroot*

OREGON  
JULY 17, 1991  
KRISTIAN O. DEGROOT  
1941

63/38-6