

FILED

JUN 23 1992

OREGON CORNER RESTORATION FORM

Section 22 Township 31S Range 5W

COUNTY SURVEYOR  
DOUGLAS COUNTY, ORE.

County DOUGLAS Date June 15, 1992

Corner Designation

22/23  
27/26

- Condition Report Only
- Not Found
- Renewed
- Unrecorded
- Surveyed In
- Referenced Out

Previous Renewals/Surveys, etc. (# 14)

U.S.B.L.M. Surveys, 1955 & 1973

Monument(s) & Accessories Found: (Condition and Source) 19B

35" D. Fir BT, face badly burned, bears S40°E (Record S45°E), ~~22~~ feet.

32" D. Fir BT, healed blaze, bears S12°E (Record S14°E), 23 1/2 feet.

21" D. Fir BT stump, badly burned, bears S36°W (Record S31°W), 28 1/2 ft.

36" D. Fir BT, healed blaze, bears N68°W, 23 1/2 feet.

19" D. Fir BT, bearing S25°W, 30 1/2 feet, Now Gone.


18" Madrone BT, face overgrown, bears N8°W, 21 1/2 feet.

Monument Detail

Sketch

Found 2 1/2" Brass Cap on a 2" Galv. Iron Pipe.

(Set Steel Fence Post Along Side.)

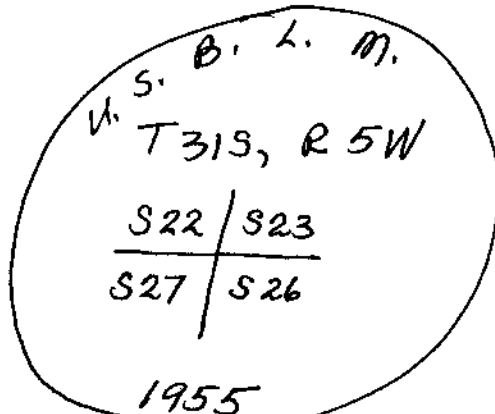

Monument Set (Procedures and Description)

N/A

New Accessories

(No trees within reasonable distance in NE Quadrant (Section 23) as is recent clearcut.)

I marked a 12" D. Fir BT, "T31S, R5W, S27, BT", S76°W, 41 1/2 feet from corner.

Location & Comments

Surveyor's Seal

Corner is About 650 feet South of Mainline Access Road.

Compass Declination 20 1/2° E

Firm/Agency Shaner Engineering

Address P.O. Box 1430 Roseburg, OR 97470

Party Chief Shaner

Notes "

Witness Jack Wright & Clem Berlier

REGISTERED  
PROFESSIONAL  
LAND SURVEYOR

Bruce A Shaner

OREGON  
OCT. 4, 1957  
BRUCE A. SHANER  
430

#1244

C.S. File No. 63/138-12c