

FILED

JK

JUL 23 1992

OREGON CORNER RESTORATION FORM

Section 27 Township 28S Range 4W

County Douglas Date July 17, 1992

COUNTY SURVEYOR
DOUGLAS COUNTY, ORE

Corner Designation

Center 1/4 S, Section 27

- Condition Report Only
- Not Found
- Renewed
- Unrecorded
- Surveyed In
- Referenced Out

Previous Renewals/Surveys, etc.

Set by U.S.B.L.M. in 1981.

Monument(s) & Accessories Found: (Condition and Source)


Found 3/4" Brass Cap on 2 1/2" Iron Pipe, from which a:

28" Cedar BT, face beveled over, bears N 73 1/2° E, 44.9 feet.

24" Cedar BT, " " " , bears S 75° W, 47.2 feet.

Monument Detail

Sketch

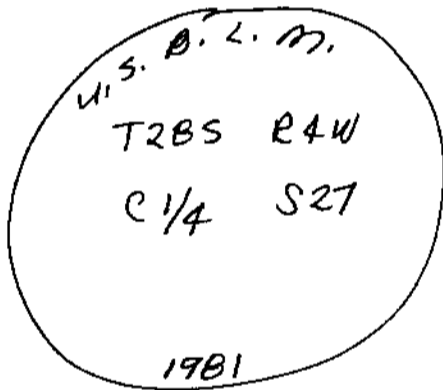

Monument Set (Procedures and Description)

None

New Accessories

None

Location & Comments

Set just above
N. Murtle County
Road.

Compass Declination 20 1/2° E

Firm/Agency Shaner Engineering, Inc.

Address P.O. Box 1430
Roseburg, Oregon 97470

Party Chief B. Shaner

Notes "

Witness Jack Wright

Surveyor's Seal



FILED

JS

JUL 23 1992

OREGON CORNER RESTORATION FORM

Section 27 Township 28S Range 4W

County Douglas Date July 17, '92

COUNTY SURVEYOR
DOUGLAS COUNTY, ORE.

Corner Designation

NE 1/4, Sec. 27

- Condition Report Only
- Not Found
- Renewed
- Unrecorded
- Surveyed In
- Referenced Out

Previous Renewals/Surveys, etc.

Set by Burt Holt, 1982.

Monument(s) & Accessories Found: (Condition and Source)

Found 2" Alum. Cap set on 5/8" Iron Rod, from which a:
12" Cedar BT, scribes visible, bears S11°E, 11² feet
14" Cedar BT, " " , bears S55¹/₂°W, 18² feet.

Monument Detail

Sketch



Monument Set (Procedures and Description)

None

New Accessories

None

Location & Comments

Surveyor's Seal

Corner lies in
Small draw
bottom, course
N-S.

Compass Declination 20¹/₂°E

Firm/Agency

Shaner Engineering, Inc.

Address P.O. Box 1430

Beesburg, Oregon 97470

Party Chief B. Shaner

Notes

Witness Jack Wright



Bruce A. Shaner



FILED

JS

JUL 23 1992

OREGON CORNER RESTORATION FORM

Section 27 Township 28S Range 4W

County Douglas Date July 17, 1992

COUNTY SURVEYOR
DOUGLAS COUNTY, ORE.

Corner Designation

CN 1/16, Sec. 27

- Condition Report Only
- Not Found
- Renewed
- Unrecorded
- Surveyed In
- Referenced Out

Previous Renewals/Surveys, etc.

Set by Burt Holt in 1982.

Monument(s) & Accessories Found: (Condition and Source)

Found 2" Alum. Cap set on 5/8" Iron Rod, from which a:
7" D. Fir BT, scribes visible, bears S 2° E, 5 1/2 feet

12" D. Fir BT, " " , bears N 52° E, 2 1/4 feet.

Monument Detail

Sketch



Monument Set (Procedures and Description)

None

New Accessories

None

Location & Comments

None.

Compass Declination 20 1/2° E

Firm/Agency

Shaner Engineering, Inc.

Address

P.O. Box 1430, Roseburg

Party Chief B. Shaner

Notes

"

Witness Jack Wright

Surveyor's Seal

REGISTERED
PROFESSIONAL
LAND SURVEYOR

Bruce A. Shaner

OREGON
OCT. 4, 1957
BRUCE A. SHANER
490

FILED

JK

JUL 23 1992

OREGON CORNER RESTORATION FORM

Section 27 Township 28S Range 4W

COUNTY SURVEYOR
DOUGLAS COUNTY, ORE.

County Douglas Date July 17, 1992

Corner Designation

CE 1/16, Sec. 27

- Condition Report Only
- Not Found
- Renewed
- Unrecorded
- Surveyed In
- Referenced Out

Previous Renewals/Surveys, etc.

Set by U.S.B.L.M. in 1981

Monument(s) & Accessories Found: (Condition and Source)

Found 3 1/4" Brass Cap set on 2 1/2" Iron Pipe from which a:
16" DBH


Douglas Fir BT, face headed over, bears S 63° W (Record
N 22 1/2° E) a distance of 16.5 feet.
N 60 1/2° E

(Per Bruce)
7/23/92

Douglas Fir BT, 14" DBH, bears S 21 1/2° E, 24.2 feet.
(Record Reads 366 links; but measured is 366 links)

Monument Detail

Sketch

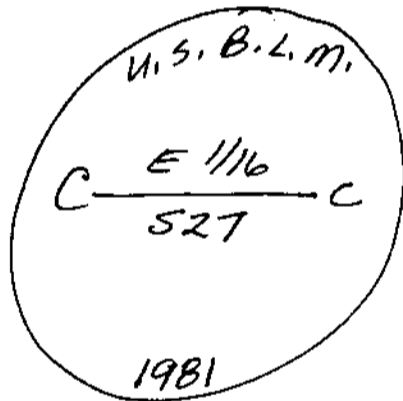

Monument Set (Procedures and Description)

None

New Accessories

None

Location & Comments

About 100 feet
above N. Myrtle
Creek at Timber
Corner.

Compass Declination 20 1/2° E

Firm/Agency Shaner Engineering, Inc.

Address P.O. Box 1430
Roseburg, Oregon 97470

Party Chief B. Shaner

Notes "

Witness J. Wright & C. Berlier

Surveyor's Seal

REGISTERED
PROFESSIONAL
LAND SURVEYOR

Bruce A. Shaner

OREGON
OCT. 4, 1957
BRUCE A. SHANER
480

* 4602AD

C.S. File No. 63/38-14