

FILED

JUL 31 1992

OREGON CORNER RESTORATION FORM

Section 6 Township 31S Range 6W

County Douglas Date 7/8/92

COUNTY SURVEYOR
DOUGLAS COUNTY, ORE.

Corner Designation

NW 1/16 Corner

- Condition Report Only
- Not Found
- Renewed
- Unrecorded
- Surveyed In
- Referenced Out


Previous Renewals/Surveys, etc. Eugene Bloom (LS 492) set a 5/8" Iron Rod for this corner in 1980 - See M 79-33

Monument(s) & Accessories Found: (Condition and Source)

30" Madrone S 2°W 8' ft. now an unprotected stump
Cat Trail goes through location of corner and other BT

Monument Detail

Sketch

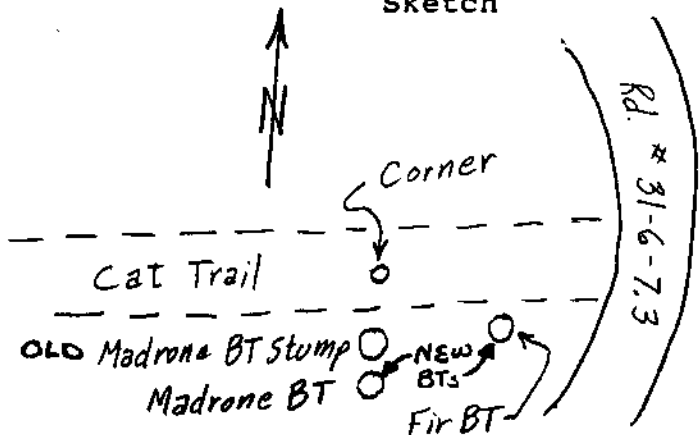

Monument Set (Procedures and Description)

Set 5/8" x 48" Iron Rod & Aluminum Cap at call distance & magnetic bearing (hand compass) from center of madrone stump. Cap marked "LS 2354 1992"

New Accessories

Scribed: 8" Fir S 54°E 14 1/4 ft. "NW 1/16 S6 BT"
20" Madrone S 2°W 12 3/4 ft. "NW 1/16 BT"

Location & Comments

Surveyor's Seal

Compass Declination 20° E
 Firm/Agency Roseburg Resources Co.
 Address P.O. Box 1088
Roseburg, OR
 Party Chief Floyd White
 Notes Bill Olson
 Witness Felix Raddatz

