

Rm. 122 - COURTHOUSE  
ROSEBURG, OR 97470

DOUGLAS COUNTY SURVEYOR

CORNER ~~XXXXXXXXXX~~

RECORD FILED

JUN 4 1992

COUNTY SURVEYOR  
DOUGLAS COUNTY, ORE.


Date 3-26-92

PH. 672-3311  
EXT. 114

Section 9 Twp. 26 S. Rge. 2 W.

Condition of Corner and Accessories:

BOTH MKD & FLAGGED. NOTHING DONE

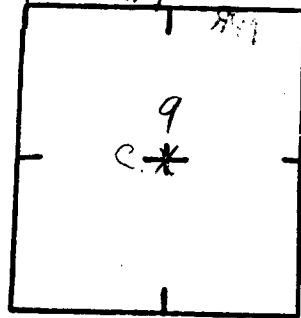

TO REACH: (Please show approximate distances, clearcuts, roads, fences, etc.) 0.4 MILES NORTH PAST THE HOUSE IN SE, SW, SEC. 9 OR 0.6 MILES FROM GATE ON SOUTH SECTION LINE  
<sup>39</sup> NORTH ON ROAD, WEST SIDE OF HONEY CREEK

Notify immediately prior to renewal visit? Yes  No

Notify following renewal visit? Yes  No

Is corner in immediate danger of being lost or disturbed? Yes  No

Name MICHAEL BRECHTEL  
Address 777 NW GARDEN VALLEY BLVD,  
ROSEBURG, OR 97470  
Telephone (503) 440-4930 EXT. 306

ADDITIONAL COMMENTS CHECK WITH PROPERTY OWNER BEFORE ENTERING.

C.S. File No. 63/140-6