

Rm. 122 - COURTHOUSE  
ROSEBURG, OR 97470

DOUGLAS COUNTY SURVEYOR

RECORD ~~FILED~~  
CORNER ~~FILED~~

PH. 672-3311  
EXT. 114


JUN 4 1992  
3/31/92

COUNTY SURVEYOR  
DOUGLAS COUNTY, OR

3-26-92

Section 16 Twp. 26S Rge. 2W

SEC. 9

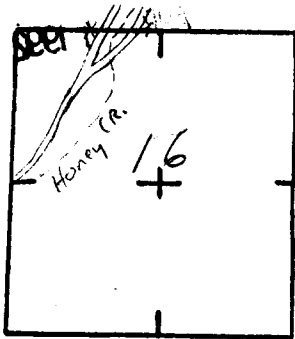

Condition of Corner and Accessories:

FOUND BOTH BT'S, A FIR BEARING N 17° E, 19 LKS DIST. IS 18" DIA., SCRIBED & TAGGED. SECOND BT, 12" DIA. HEMLOCK, BEARS S. 65° W., 4 LKS DIST., SCRIBED & TAGGED. PLACED LOCATOR TAG WEST OF PVT. DRIVEWAY GATE.  
W 1/16 S 9 COR.  
S 16

TO REACH: (Please show approximate distances, clearcuts, roads, fences, etc.) DRIVE 1.8 MILES ON THE 17 RD TO THE SECOND DRIVEWAY ON THE LEFT, BEFORE THE CREEK CROSSING AND TO THE GATE, CORNER IS 80' WEST OF DRIVEWAY

Notify immediately prior to renewal visit? Yes  No

Notify following renewal visit? Yes  No

Is corner in immediate danger of being lost or disturbed? Yes  No

Name MICHAEL BRECHTEL

Address 777 NW. GARDEN VALLEY RD

ROSEBURG, OR 97470

Telephone (503) 440-4930 EXT. 306

ADDITIONAL COMMENTS

\_\_\_\_\_  
\_\_\_\_\_  
\_\_\_\_\_  
\_\_\_\_\_

C.S. File No. 63/140-7

3-17-92

FILED

APR 2 1992

COUNTY SURVEYOR  
DOUGLAS COUNTY, ORE.

Douglas County Surveyor

Enclosed are visitation records for several corners I visited  
in the past year.

There is one Renewal request.

Bill May  
North Umpqua Resource Area  
BLM  
Roseburg  
6-440-4930 Ext. 306

*Rec'd 3/18/92*

*Treat as corner reports  
Per ED*

U.S. File No. 63/140