

Rm. 122 - COURTHOUSE
ROSEBURG, OR 97470

DOUGLAS COUNTY SURVEYOR

FILED


UPDATE INFO
CORNER

JUN 4 1992

PH. 672-3311
EXT. 114

Section ^{15, 14,} 22, 23 Twp. 26S Rge. 2W

COUNTY SURVEYOR
DOUGLAS COUNTY, ORE. 4-13-92

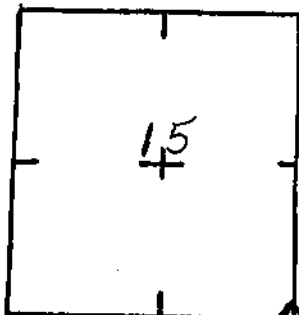

Condition of Corner and Accessories: FOUND MONUMENT, OK. FOUND FOUR BT'S
A FIR, 30 INS. DIAM., BEARS S 70°W, 54 LKS. WITH HEALED BLAZE, A FIR, 20 INS. DIAM.,
BEARS N 51°E 55 LKS. DIST. WITH PARTIALLY OPENED BLAZE, A FIR, 29 INS. DIAM.,
SEC. BEARS N 70°W, 75 LKS. DIST. WITH HEALED BLAZE, A CEDAR 18 INS. DIAM.,
14 BEARS S 2°E, 194 LKS. DIST. WITH PARTIALLY HEALED BLAZE.
2 OTHER BT'S STUMPS NOT FOUND

TO REACH: (Please show approximate distances, clearcuts, roads, fences, etc.) FROM LOCATOR TAG ON HWY 138, N 1°E, 830 FT
TO CORNER ACROSS BACK OF TRAILER COURT & UP HILL. CORNER IS LOCATED ON EDGE
OF EXCAVATED FLAT CLEARING. LOCATOR TAG IS 70' WEST FROM
SUZAN CREEK TRAILER PARK DRIVEWAY ON SOUTH SIDE OF HWY 138.

Notify immediately prior to renewal visit? Yes No
Notify following renewal visit? Yes No
Is corner in immediate danger of being lost or disturbed? Yes No

Name MICHAEL BRECHTEL
Address 777 NW GARDEN VALLEY
ROSEBURG, OR 97470
Telephone 440-4930 EXT. 306

ADDITIONAL COMMENTS MAP & ORIGINAL NOTES INCLUDED

C.S. File No. 63/140-9

dist.,
 dist.,
 dense
 slope.

Dependent Resurvey of a Portion of the Subdivisional Lines,
 T. 26 S., R. 2 W.
 (Restoring the 1883 survey by John A. McQuinn
 and the 1918 revision survey by Fred Menach)

From the cor. of secs. 14, 15, 22, and 23, monumented with a basalt
 stone, 8 x 6 x 6 ins., set by Gibbs in 1909, with 3 notches on the S.
 and 2 notches on the E. edge; perpetuated and recorded by J. W. Byron,
 Deputy County Surveyor, in 1957, with an iron post, 1½ ins. diam.,
 protruding 8 ins. above ground, firmly set alongside the marked stone,
 with brass cap mhd.

T 26 S R 2 W
 SEC 15/16
 22/23
 1957

Dependent Resurvey of a Portion of the Subdivisional Lines, T. 26 S., R. 2 W.

Chains from which 1883 bearing trees

FOUND A sawed fir stump, 28 ins. diam., bears S. 46½° E., 86 lks. dist., with a healed blaze. (Record bearing, S. 50° E.)

FOUND A fir, 25 ins. diam., bears S. 71½° W., 52½ lks. dist., with a healed blaze. (Record bearing and dist., S. 70° W., 54 lks.)

and 1918 bearing trees

FOUND A fir, 16 ins. diam., bears N. 51½° E., 65 lks. dist., with scribe marks 26 visible on a partially opened blaze. (Record dist., 64 lks.)

FOUND A chopped madrone stump, 7 ins. diam., bears S. 35½° W., 23½ lks. dist., with illegible scribe marks visible on a partially healed blaze. (Record bearing and dist., S. 33° W., 25 lks.)

FOUND A fir, 24 ins. diam., bears N. 70½° W., 75 lks. dist., with a healed blaze.

and County Surveyor's bearing tree

FOUND A cedar, 14 ins. diam., bears S. 1½° E., 194½ lks. dist., mhd. T26S R2W S23 CS BT.

N. 1° 36' E., bet. secs. 14 and 15, marking and blazing the true line.

Ascend 98 ft. over SE. slope, through heavy timber and dense undergrowth.

3.15 Leave timber, enter pasture land, edge bears NE. and SW.

15.10 Leave pasture land, enter timber, edge bears E. and W.

19.40 Top of ascent, slopes E.; desc. 37 ft. over NE. slope.

23.60 Dirt access road, 25 lks. wide, bears NW. and SE.

25.50 Creek, 3 lks. wide, course SE.; asc. 127 ft. over SE. slope.

27.32 Three-wire transmission line, bears E. and W.

28.77 Three-wire transmission line, bears E. and W.

40.38 Point for the ¼ sec. cor. of secs. 14 and 15, at proportionate distance; there is no remaining evidence of the original corner.

Set an iron post, 28 ins. long, 2½ ins. diam., 22 ins. in the ground, and in a mound of stone, 1½ ft. base, to top, with brass cap mhd.

T 26 S R 2 W
 ↑
 S 15 | S 14
 1959

3-17-92

FILED

th
APR 2 1992

Douglas County Surveyor

COUNTY SURVEYOR
DOUGLAS COUNTY, ORE.

Enclosed are visitation records for several corners I visited
in the past year.

There is one Renewal request.

Bill May
North Umpqua Resource Area
BLM
Roseburg
6-440-4930 Ext. 306

Rec'd 3/18/92

*Treat as corner reports
Per ED*

U.S. File No. 63/140