

M 116-77

FILED *J*

OREGON CORNER RESTORATION FORM

MAY 6 1993

Section 12 Township 21S Range 6W

County Douglas Date 04-15-93

COUNTY SURVEYOR  
DOUGLAS COUNTY, ORE.

CORNER DESIGNATION

West 1/4 Corner  
Section 12

- Condition Report Only
- Not Found
- Renewed
- Unrecorded
- Surveyed In
- Referenced Out

Previous Renewals/Surveys, etc. 1884 G.L.O. Survey by William Wright.

Monument(s) & Accessories Found: (Condition and Source)


No monument found.

Found: 16" Downed Fir, N58E, 13.2' (No Marks), 1884 B.T. Rec. N58E, 13.2'  
(1945 G.L.O. Bearing tree tag nailed to tree)

18" Fir Stub, S87W, 4.6' (Chaining Notch Vis.), 1884 B.T.

Record: S87W, 4.6'

Monument Detail

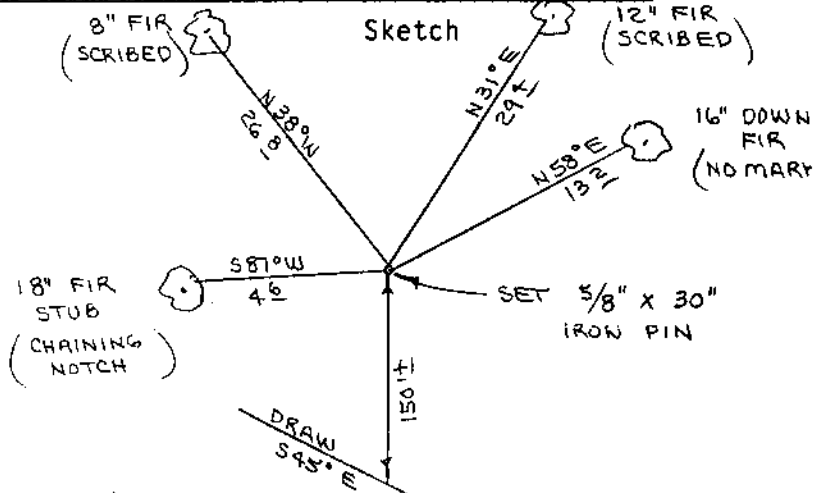

Monument Set (Procedures and Description)

Set 5/8" x 30" iron pin with yellow plastic cap. Iron pin set from  
Original 1884 Southwest bearing tree.

Set: 8" Fir, N38W, 26.8' (Scribed/Metal Washer/Painted Red)

12" Fir, N31E, 29.4' (Scribed/Metal Washer/Painted Red)

Painted both bearing trees red.

New Accessories

Location & Comments

Corner lies on South slope Compass Declination 20 1/2

about 150' North of draw. Firm/Agency Roberts

Draw bears S45E. Surveying, Inc.

Address 29 West 29th St.

Eugene, Oregon 97405

Party Chief Stuart Duce

Notes \_\_\_\_\_

Witness Brad Cole.

Surveyor's Seal



EXPIRES 12-31-84

C.S. File No. 63/153

# 151  
C