

M 116-77

FILED JP

OREGON CORNER RESTORATION FORM

MAY 6 1993

Section 12 Township 21S Range 6W

County Douglas Date 04-14-93

COUNTY SURVEYOR
DOUGLAS COUNTY, ORE.

CORNER DESIGNATION

N.W. Corner
Section 12

- Condition Report Only
- Not Found
- Renewed
- Unrecorded
- Surveyed In
- Referenced Out

Previous Renewals/Surveys, etc. 1884 G.L.O. Survey by William Wright.

1961 Douglas County Renewal by Milo Godfrey, See G.S. File #49/143.

A 1961-1962 B.L.M. Survey by Norman J. McDonald.

Monument(s) & Accessories Found: (Condition and Source)

Found 1961 Douglas County Iron Pipe and Brass Cap set firmly in the ground.

24" Fir Stump, S11E, 18.4' (Scribe Vis.), 1884 BT. Rec. S11E, 18.5'

8" Dead Madrone, N17E, 22.7' (Scribe Vis.), 1961 BT. Rec. N17E, 23.1'

15" Fir, S67W, 32.9' (Scar Vis.), 1961 BT. Rec. S67W, 33.5'

16" Fir, N56W, 20.0' (Scar Vis.), 1961 BT. Rec. N56W, 20.2'


36" Fir, S12E, 31.7' (Scar Vis.), 1961 BT. Rec. S13 1/2 E, 33.0'

12" Fir, S65W, 38.6' (Scar Vis.), 1962 BT. Rec. S65W, 38.9'

18" Fir, N74E, 53.5' (Scar Vis.), 1962 BT. Rec. N75E, 56.8'

34" Fir, N03W, 46.5' (Scar Vis.), 1962 BT. Rec. N03W, 46.2'

Monument Detail

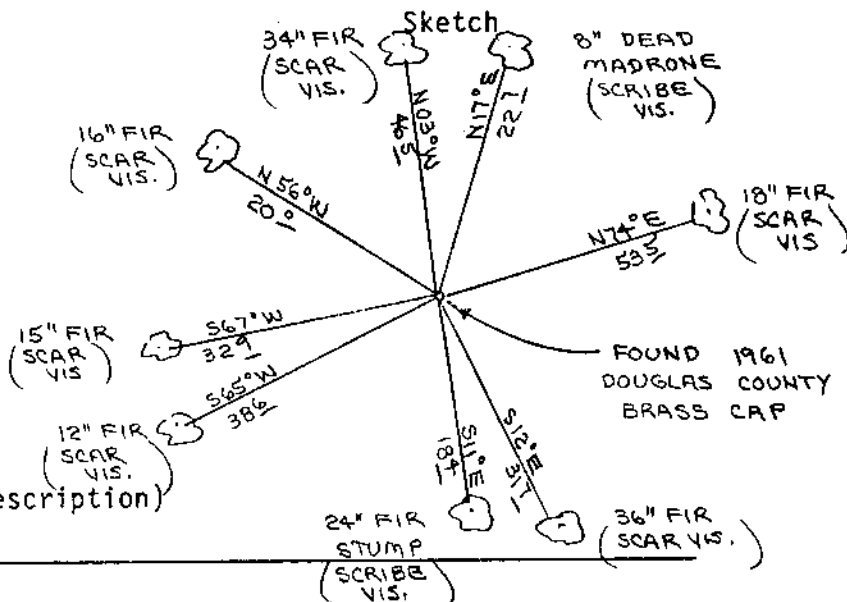

Monument Set (Procedures and Description)

New Accessories

Painted all bearing trees red.

Location & Comments

Corner lies on South slope about 220' North of draw. Compass Declination 20 1/2

Draw bears N64W and S64E. Firm/Agency Roberts Surveying, Inc.

Corner also lies about 70' South of dirt cat road Address 29 West 29th St. Eugene, Oregon 97405

Party Chief Stuart Duce

Notes _____

Witness Brad Cole

Surveyor's Seal



EXPIRES 12-31-84 -2

G.S. File No. 63/153