

OREGON CORNER RESTORATION FORM

Section 12 Township 21S Range 6W

MAY 6 1993

County Douglas Date 04-15-93

COUNTY SURVEYOR
DOUGLAS COUNTY, OREGON

CORNER DESIGNATION

South 1/4 Corner
Section 12

- Condition Report Only
- Not Found
- Renewed
- Unrecorded
- Surveyed In
- Referenced Out

Previous Renewals/Surveys, etc. 1884 G.L.O. Survey by William Wright.
1983 B.L.M. Survey by Wayne L. Ridgers.

Monument(s) & Accessories Found: (Condition and Source)

Found 1983 B.L.M. Brass Cap set firmly in the ground.


50" Fir Stump, N30E, 14.5'(Scribe Vis.), 1884 BT. Rec. N31E, 15.2'

9" Fir, N33W, 5.1'(Scar Vis.), 1983 BT. Rec. N33 1/2 W, 5.3'

12" Fir, S16E, 29.1'(Scar Vis.), 1983 BT. Rec. S16 1/2 E, 29.0'

Painted bearing trees red.

Monument Detail

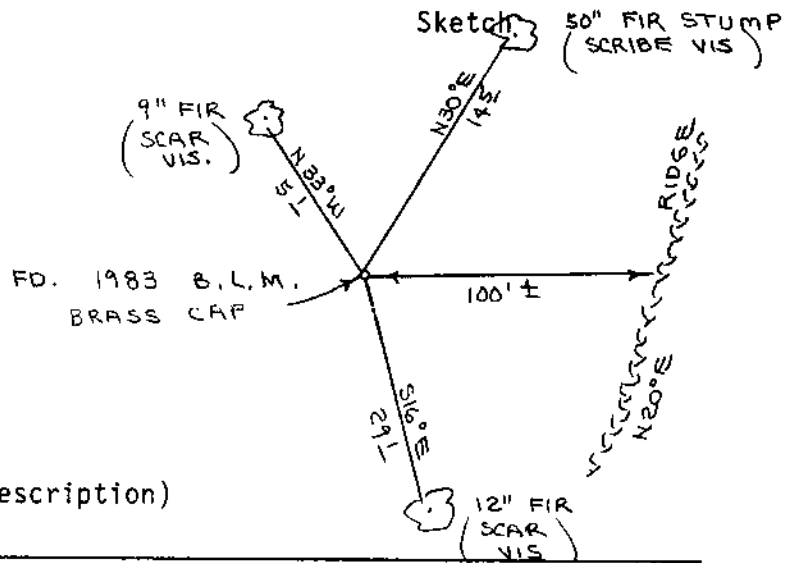

Monument Set (Procedures and Description)

New Accessories

Location & Comments

Corner lies on S.W. slope about 100' West of ridge. Compass Declination 20 1/2

Ridge bears N20E and S20W. Firm/Agency Roberts


Surveying, Inc. Address 29 West 29th St.

Eugene, Oregon 97405 Party Chief Ted Baker

Notes _____

Witness Kent Baker

Surveyor's Seal

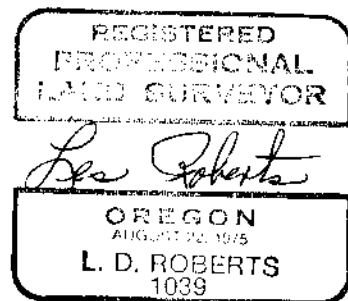

EXPIRES 12-31-84