

OREGON CORNER RESTORATION FORM

Section 12 Township 21S Range 6W

MAY 6 1993

County Douglas Date 04-16-93

COUNTY SURVEYOR
DOUGLAS COUNTY, ORE.

CORNER DESIGNATION

East 1/4 Corner
Section 12.

- Condition Report Only
- Not Found
- Renewed
- Unrecorded
- Surveyed In
- Referenced Out

Previous Renewals/Surveys, etc. 1855 G.L.O. Survey by Gordon and Gardner.
A 1961 Douglas County Renewal by Milo Godfrey. See C.S. File #49/89.


Monument(s) & Accessories Found: (Condition and Source)

Found 1961 Douglas County Brass Cap set firmly in the ground.

23" Hemlock, S86E, 19.3' (Scar Vis.), 1961 BT. Rec. S87E, 19.2'

30" Hemlock Snag, S72W, 17.9' (Scar Vis.), 1961 BT. Rec. S71W, 18.2'

Monument Detail

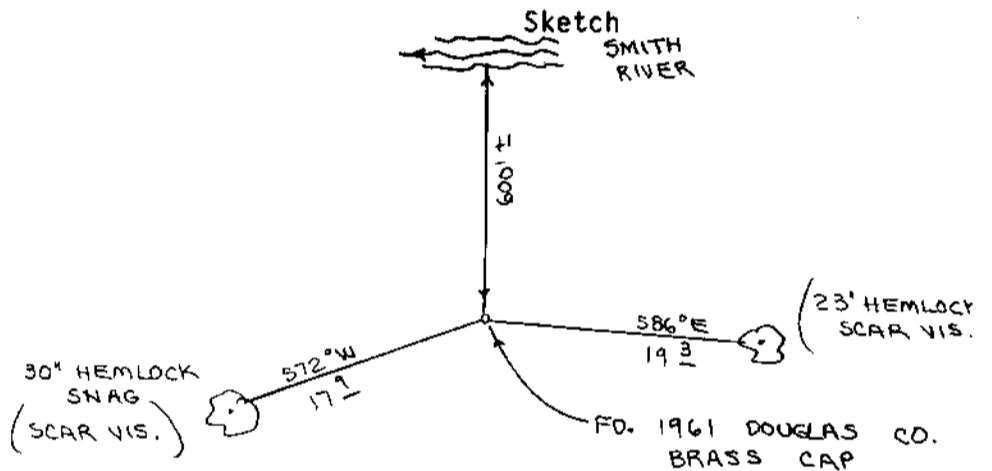

Monument Set (Procedures and Description)

New Accessories

Location & Comments

Corner lies on gentle North Compass Declination 20 1/2
slope about 600' South of Firm/Agency Roberts
Smith River.

Surveying, Inc.
Address 29 West 29th St.
Eugene, Oregon 97405
Party Chief Ted Baker

Notes _____
Witness Kent Baker

Surveyor's Seal

