

M 116-77

FILED JP

OREGON CORNER RESTORATION FORM

Section 12 Township 21S Range 6W

MAY 6 1993

County Douglas Date 04-13-93

COUNTY SURVEYOR  
DOUGLAS COUNTY, ORE.

CORNER DESIGNATION

North 1/4 Corner  
Section 12.

- Condition Report Only
- Not Found
- Renewed
- Unrecorded
- Surveyed In
- Referenced Out

Previous Renewals/Surveys, etc. 1884 G.L.O. Survey by William Wright.  
1961-1962 B.L.M. Survey by Norman J. McDonald.

Monument(s) & Accessories Found: (Condition and Source)


Found 1962 B.L.M. Brass Cap set firmly in the ground.

22" Fir Stump, S45W, 14.4' (Scribe Vis.), 1884 BT. Record S45W, 17.8'

16" Maple, N12W, 25.5' (Scar Vis.), 1962 BT. Record N11W, 25.7'

Painted all bearing trees red.

Monument Detail

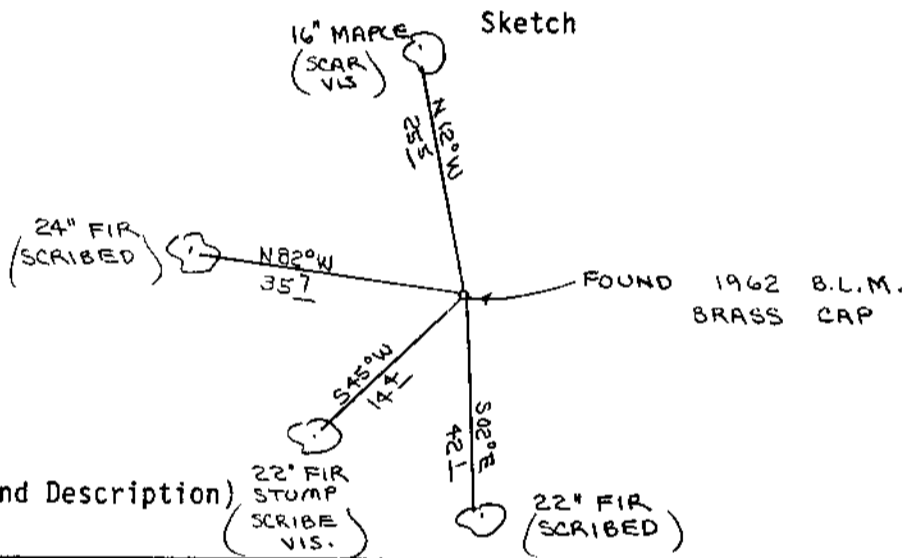

Monument Set (Procedures and Description)

New Accessories

Set: 22" Fir, S02E, 42.1' (Scribed/Metal Washer/Painted Red)

24" Fir, N82W, 35.7' (Scribed/Metal Washer/Painted Red)

Location & Comments

Compass Declination 20 1/2

Firm/Agency Roberts

Surveying, Inc.

Address 29 West 29th St.


Eugene, Oregon 97405

Party Chief Stuart Duce

Notes \_\_\_\_\_

Witness Brad Cole

Surveyor's Seal

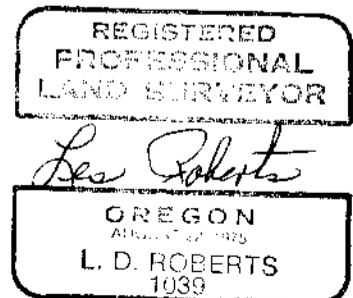

EXPIRES 12-31-84

28. File No. 63/153