

M 116-77

FILED *JP*

OREGON CORNER RESTORATION FORM

Section 12 Township 21S Range 6W

MAY 6 1993

County Douglas Date 04-22-93

COUNTY SURVEYOR  
DOUGLAS COUNTY, OR.

CORNER DESIGNATION

Center 1/4 Corner  
Section 12


- Condition Report Only
- Not Found
- Renewed
- Unrecorded
- Surveyed In
- Referenced Out

Previous Renewals/Surveys, etc. None

Monument(s) & Accessories Found: (Condition and Source)

None

Monument Detail

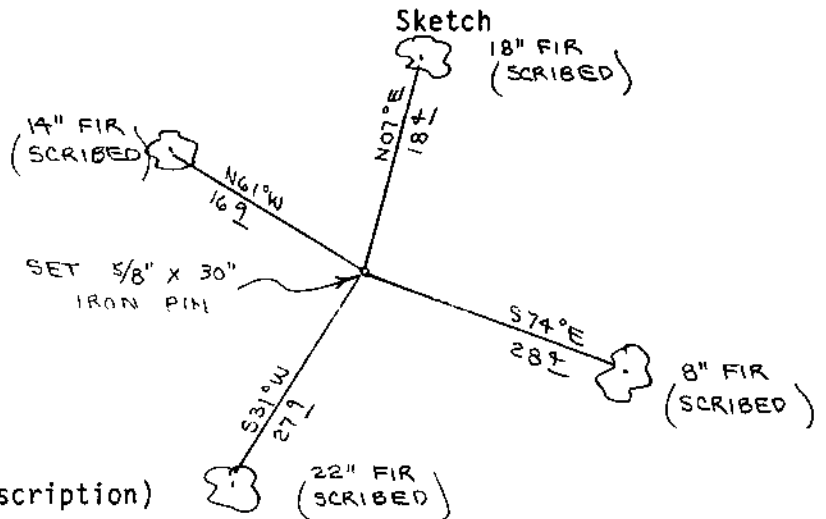

Monument Set (Procedures and Description)

Set 5/8" x 30" iron pin with yellow plastic cap. See filed survey for survey procedures.


New Accessories

- 8" Fir, S74E, 28.4' (Scribed/Metal Washer/Painted Red)
- 14" Fir, N61W, 16.9' (Scribed/Metal Washer/Painted Red)
- 18" Fir, N07E, 18.4' (Scribed/Metal Washer/Painted Red)
- 22" Fir, S31W, 27.9' (Scribed/Metal Washer/Painted Red)

Location & Comments

Compass Declination 20 1/2  
 Firm/Agency Roberts Surveying, Inc.  
 Address 29 West 29th St. Eugene, Oregon 97405  
 Party Chief Stuart Duce  
 Notes \_\_\_\_\_  
 Witness Fletcher Butler

Surveyor's Seal

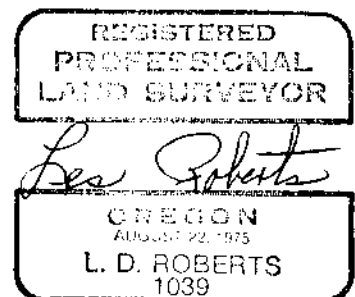

EXPIRES 12-31-84

D.S. File No. 63/153-6

#152  
CW