

OREGON CORNER RESTORATION FORM

MAY 11 1993

Section 28 Township 30S Range 7W

COUNTY SURVEYOR
DOUGLAS COUNTY, ~~OR~~

County DOUGLAS Date 4/27/93

Corner Designation

20	21
29	28

- Condition Report Only
- Not Found
- Renewed
- Unrecorded
- Surveyed In
- Referenced Out

Previous Renewals/Surveys, etc. R-91

Monument(s) & Accessories Found: (Condition and Source)

FND: DCS IPBC-1965

D. FIR, 18", N45W, 41.5', PISTOL BUTT

D. FIR, 9", N23E, 5.9', BURNT SNAG

ORIG D. FIR, 40", N69W, 22.4', Good Condition

D. FIR, 22", S3E, 11.7', 6' Tall Stump

D. FIR, 26", S81W, 26.9', 3' TALL STUMP

Monument Detail

Sketch

Monument Set (Procedures and Description)

New Accessories

Location & Comments

STEEL FENCE POSTS
WERE SET ON LINE
FROM THIS CORNER
EAST TO THE 1/4 COR.

Compass Declination

Firm/Agency ROSEBURG

RESOURCES Co.

Address P.O. Box 1088


Roseburg, OR 97470

Party Chief FELIX RADDATZ


Notes

Witness BILL OLSON

Surveyor's Seal

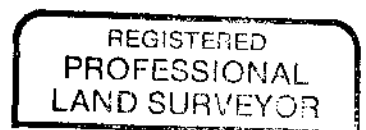

Mark F. Smalley

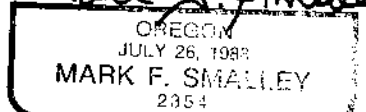

Expires 12/31/94