

FILED JC

OREGON CORNER RESTORATION FORM

MAY 11 1993

Section 22 Township 30S Range 7W
County DOUGLAS Date 4/27/93

COUNTY SURVEYOR
DOUGLAS COUNTY, OREGON

Corner Designation

1/4 522
527

- Condition Report Only
- Not Found
- Renewed
- Unrecorded
- Surveyed In
- Referenced Out

Previous Renewals/Surveys, etc. R-85

Monument(s) & Accessories Found: (Condition and Source)

FOUND: 1965 COUNTY BCIP

FIR, 17", N45 1/2 W, 15.8', GOOD CONDITION

FIR, 13", S41 1/4 E, 5.9', GOOD CONDITION

Monument Detail

Sketch


Monument Set (Procedures and Description)

New Accessories

Location & Comments

FENCE POSTS WERE Compass Declination _____
SET ON LINE FROM Firm/Agency ROSEBURG,
THIS COR. WEST TO RESOURCES COMPANY
THE SECTION CORNER Address PO BOX 1088
ROSEBURG, OR
CORNER FALLS 25' Party Chief FELIX RADDATZ
WEST OF ROAD Notes _____
 Witness BILL OLSON

Surveyor's Seal

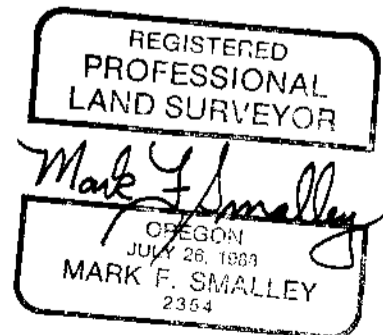

Expires 12/31/94