

FILED *x*

OREGON CORNER RESTORATION FORM

MAY 11 1993

Section 28 Township 30S Range 7W
County DOUGLAS Date 4/27/93

COUNTY SURVEYOR
DOUGLAS COUNTY, ORE

Corner Designation

1/4 S21
S28

- Condition Report Only
- Not Found
- Renewed
- Unrecorded
- Surveyed In
- Referenced Out

Previous Renewals/Surveys, etc. R-87

Monument(s) & Accessories Found: (Condition and Source)

FOUND D. FIR, 30", N55E, 6.6', GOOD HEALED FACE
D. FIR, 28", S34W, 9.4', GOOD HEALED FACE

Monument Detail

Sketch


Monument Set (Procedures and Description)

New Accessories

Location & Comments

FENCE POSTS WERE Compass Declination _____
SET ON LINE FROM Firm/Agency ROSEBURG
THIS CORNER WEST TO RESOURCES Co.
THE SECTION CORNER Address P.O. Box 1088
ROSEBURG, OR 97470
 Party Chief FELIX RADOATZ
 Notes _____
 Witness BILL OLSON

Surveyor's Seal

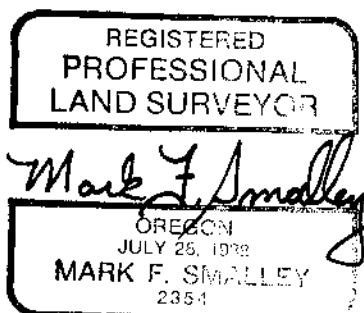

Expires 12/31/94