

FILED JP

OREGON CORNER RESTORATION FORM

MAY 17 1993

S.W. CORNER Section 18 Township 23S Range 5W

COUNTY SURVEYOR
DOUGLAS COUNTY, ORE.

County DOUGLAS Date 3/27/93

Corner Designation

- Condition Report Only
- Not Found
- Renewed
- Unrecorded
- Surveyed In
- Referenced Out

Previous Renewals/Surveys, etc. 1943 G.L.O.

Monument(s) & Accessories Found: (Condition and Source)

2" IRON PIPE WITH 1943 G.L.O. BRASS CAP
37" FIR SNAG, S34W (SOLAR) (REMOVED S45W) 69.7 ft. from 1943 B.C.
(CHOPPED IN TO VISIBLE SCRIBE)

- OVER -

Monument Detail

Sketch

Monument Set (Procedures and Description)

2" X 42" IRON PIPE WITH BRASS CAP
SEE BACK OF SHEET

New Accessories

11" FIR - N49 1/4 E - 28° - SCRIBED "T23S R5W S18 BT"
14" FIR - S28E - 27° - SCRIBED "T23S R5W S19 BT"
20" FIR - S33 1/2 W - 12° - SCRIBED "T23S R6W S24 BT"
15" FIR - N82 1/2 W - 23° - SCRIBED "T23S R6W S13 BT"

Location & Comments

Surveyor's Seal

SOLAR BRG TO NEAREST 1/4 Compass Declination

PEEL BAKER LAND SURVEYING INC.

Firm/Agency


1385 OAK ST. SUITE 3

Address EUGENE OR 97404

Party Chief

Notes

Witness

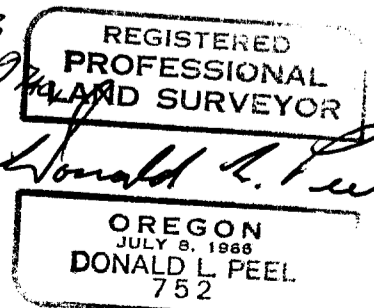

C.S. File No. 63/153-11

139 T23-5
103 T23-6

4

FEB 17 1943


ROVEVALE & THUD
THE 1943 G.L.O. MONUMENT
WAS SET AT

PROPORTIONATE DISTANCE, NO REMAINING EVIDENCE
OF ORIGINAL CORNER.

I FOUND EVIDENCE OF THREE OF THE ORIGINAL
(1853) BEARING TREES. I ADVISED THE B.L.M.
OF FINDING SAID B.T. & THEY SENT SOMEONE
TO VERIFY THE FIND. THEY ADVISED ME TO
SET MY OWN CORNER MONUMENT ^{SAGED ON 1853 B.T.} AND
THEY WOULD ACCEPT MY MONUMENT.

I SET A 2" X 42" IRON PIPE WITH BRASS CAP

(MKD).

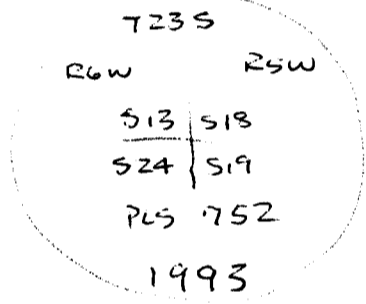

ROTTED REMAINS OF 28" FIR (PITH STUB & BARK RING, ROTTED OFF)
AT GROUND LEVEL - NO MARKS
N 81 3/4 W, 10.5 FT

36" FIR STUMP, (I CHOPPED OPEN TO VISIBLE SCRIBE "T235 524")
S 62 W, 17.2 FT.

ROTTED REMAINS OF A 32" FIR OR POSSIBLY A DOUBLE FIR
AS THERE WAS SOME BARK ON THE INSIDE OF THE ROTTED
CLUMP OF WOOD (NO MARKS)
S 55 1/4 E, 10.5 FT.

1943 B.T. (37" FIR SNAG - VISIBLE SCRIBE) - S 22 1/2 W - 78.3 FT.