

JUL 19 1993

CERTIFIED RECORD OF LAND CORNER MONUMENTATION


COUNTY SURVEYOR
DOUGLAS COUNTY, ORE.

History of original corner establishment:

This corner was originally established as the Common Corner for sections 25,30,31 and 36 by John A. McQuinn, U.S. Deputy Surveyor, under Contract No. 466 in 1883.

This corner was re-established as the section corner for sections 25 and 36 only by Fred Mensch under Contract No. 797 in 1910.


The stone set in 1910 was replaced by a 3" iron pipe with Brass Cap in 1916.

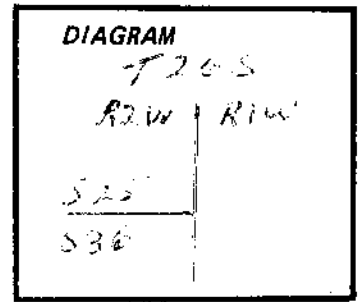

Description of corner evidence found:

Found a 3" iron pipe, 12" above ground in a 24" mound of stone with a 3" Brass Cap marked:

U.S. General Land Office Survey
T26S

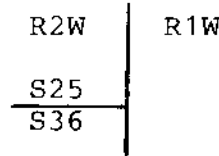

from which bearing trees:

40" Cedar bears S84°W 23.4 feet with partly visible scribing
28" Douglas Fir with healed blazes was blown over.

Description of monument and accessories established to perpetuate the original location of this corner:

I established new bearing tree:
30" Douglas Fir with double blaze, upper scribed T26S, R2W S25, lower blaze scribed BT with nail and washer stamped LS 839 bears N 78°W 42.8 feet.

All bearing trees have a 6" red band painted around the tree and the blaze face painted red. USFS sign 54-3, BEARING TREE, and 54-9, LAND SURVEYING MONUMENT, are nailed to all bearing trees.

REGISTERED
OREGON
LAND SURVEYOR

JULY 12 1968
DONALD A. BENTZ
839

Office of County Surveyor County of Douglas
State of Oregon I hereby certify that the within instrument was filed in this office
for record on the 19th day of July 1993
Janet R. Lundeen by *Janet R. Lundeen*
(COUNTY OFFICIAL) (DEPUTY)

T 26 S R 2 W S 25
S 36

U.S. File No. 63/153-12
C