


CERTIFIED RECORD OF LAND CORNER MONUMENTATION

History of original corner establishment:

This corner was originally established as the 1/4 corner for section 36 only by John A. McQuinn, U.S. Deputy Surveyor, under Contract No. 466 in 1883. Set 3" by 3" by 36" Cedar post set 2 1/4" into ground.

Fred Mensch under Contract No. 797 in 1910 retraced McQuinn's survey of 1883 and found no evidence of corner set by McQuinn. Re-established corner and set stone.

In 1916 Fred Mensch re-established 1/4 corner and set Brass Cap which the stone set in 1910 bears N 45° 15' W 1.06 Ch. destroyed stone and bearing trees set in 1910 survey.

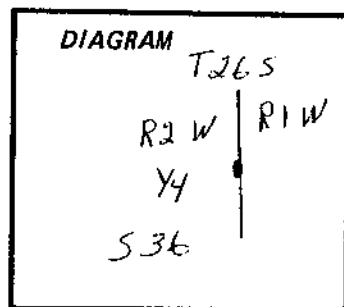

Description of corner evidence found:

U.S. General Land Office Survey

Found 1" iron pipe, firmly set  
10" above ground in a 2 ft. dia.  
mound of stone with a 2 1/2" Brass cap marked

From which bearing trees:

50" Douglas Fir Stump with healed blaze bears N 7° W 15.3 feet  
41" Douglas Fir Stump with healed blaze bears S 87° W 32.3 feet

Y4 SEC.  
1916

Description of monument and accessories I established to perpetuate the original location of this corner:

I established new bearing trees and bearing object.  
5" Fir with double blaze, upper scribed 1/4 Sec 36,  
lower blaze scribed BT with nail and washer stamped  
LS 839 and bears S 41° W 21.3 feet.


Set spike in center of 50" Douglas Fir Stump which  
bears N 7° W 15.3 feet

**FILED** X

JUL 19 1993

**COUNTY SURVEYOR  
DOUGLAS COUNTY, ORE.**

All bearing trees have a 6" red band painted  
around the trees and the blaze face painted red.  
USFS sign 54-3, Bearing tree, and 54-9, Land Surveying  
Monument, are nailed to all bearing trees.

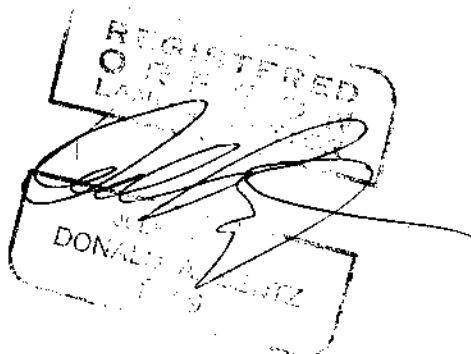

Office of...County...Surveyor..... County of...Douglas.....  
State of...Oregon..... I hereby certify that the within instrument was filed in this office  
for record on the 19th day of.....July..... 1993.  
Janet R. Lundeen..... by Janet R. Lundeen.....  
(COUNTY OFFICIAL) (DEPUTY)