

JUL 19 1993

CERTIFIED RECORD OF LAND CORNER MONUMENTATION


COUNTY SURVEYOR  
DOUGLAS COUNTY, ORE.

History of original corner establishment:

This corner was originally established by John A. McQuinn U. S. Deputy Surveyor under Contract No. 466 in 1883.

This corner was re-established by Fred Mensch under Contract No. 797 in 1910.


Fred Mensch set Brass Cap in 1916.

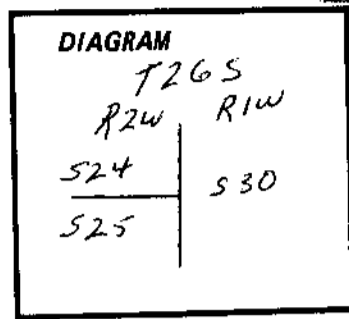

Description of corner evidence found:

Found a 3" iron pipe firmly set 8" above ground with a 3 1/2" Brass Cap Marked:

U. S. General Land Office Survey

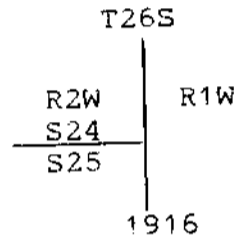

from which bearing trees:

31" Cedar bears S74°W 19.1 ft. with a partly healed lower blaze and an open upper blaze with no scribing

40" Douglas Fir stump bears N7°W 70.0 ft. with healed blaze.

Description of monument and accessories established to perpetuate the original location of this corner:

I established new bearing tree:

8" White Fir with upper blaze scribed T26S R1W S30, lower blaze scribed BT with brass washer stamped LS 839 Bears S21°E, 13.1 feet.

All bearing trees have a 6" red band painted around the tree and the blaze face painted red. USFS sign 54-3, BEARING TREE, and ~~sign 9~~ 54-9, LAND SURVEYING MONUMENT, are nailed to all bearing trees.

REGISTERED  
OREGON  
LAND SURVEYOR

JULY 12, 1993  
DONALD A. BENTZ  
839

Office of.....County...Surveyor..... County of.....Douglas.....  
State of.....Oregon....., I hereby certify that the within instrument was filed in this office  
for record on the 19th day of.....July..... 1993  
.....Janet R. Lundeen..... by Janet R. Lundeen (DEPUTY)

T.26-1 REN # 122 ✓  
T.26-2 REN # 146 ✓

C.S. File No. 63/153-14  
C