

JUL 19 1993


CERTIFIED RECORD OF LAND CORNER MONUMENTATION

COUNTY SURVEYOR
DOUGLAS COUNTY, ORE.

History of original corner establishment:

This corner was original established by Rufus S. Moore, Deputy Surveyor, under contract No. 475 in 1883.

The original stone monument set in 1883 was replaced with a brass cap in 1963 by James W. Byron, Deputy County Surveyor.

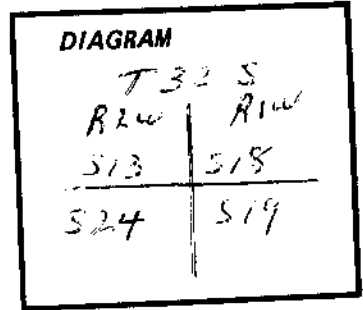

Description of corner evidence found:

Found bearing trees:


- 8" Yew with visible scribing bears N50° E 9.9 feet
- 18" Yew with visible scribing bears S40° E 18.3 feet
- 24" W. Fir with healed blaze bears N55° W 82.7 feet
- 12" Fir with healed blaze bears S75° W 22.6 feet

Found 1" iron pipe with brass cap lying on the ground, reset per record bearing and distances from existing bearing trees.

Description of monument and accessories established to perpetuate the original location of this corner:

RE-SET 1" iron pipe with County Surveyor's Office Brass Cap, monument 16" above ground with 24" diameter mound of stone marked:

County Surveyor's Office

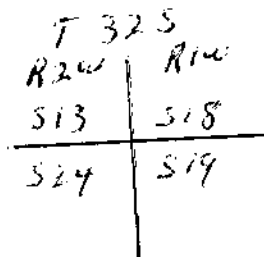

Re-set monument using record distance and record bearings from existing bearing trees.

All bearing trees have a 6" red band painted around the tree and the blazed face painted red. USFS sign 54-3, BEARING TREE, and sign 54-9, LAND SURVEYING MONUMENT, are nailed to all bearing trees.

REGISTERED
OREGON
LAND SURVEYOR

[Signature]
JULY 12, 1968
DONALD A. BENTZ
839

Office of...County...Surveyor..... County of...Douglas.....
 State of...Oregon....., I hereby certify that the within instrument was filed in this office
 for record on the 9th day of.....July..... 19.93
Janet R. Lundeen..... by *[Signature]*.....
 (COUNTY OFFICIAL) (DEPUTY)

T 32 S
R 24 W 135 X

C.S. File No. 63/153-15
C