

M 112-78

FILED ^{JC}

OREGON CORNER RESTORATION FORM

JUL 23 1993

Section 30 Township 2B5 Range 8W

COUNTY SURVEYOR
DOUGLAS COUNTY, ORE.

County Douglas Date July 23, '93

Corner Designation

$\frac{1}{4} S \frac{30}{31}$

- Condition Report Only
- Not Found
- Renewed
- Unrecorded
- Surveyed In
- Referenced Out

Previous Renewals/Surveys, etc.

Renewed by C.S.B.L.M. in 1964.


Monument(s) & Accessories Found: (Condition and Source)

I found a 3/4" Brass Cap on a 2" Iron Pipe from which a:
22" D. Fir BT (record 10"), face overgrown, bears N 6 1/2° W,
18 1/2 feet.

12" D. Fir BT (record 9"), face overgrown, bears S 8 1/2° W,
38 1/2 feet.

Monument Detail

Sketch

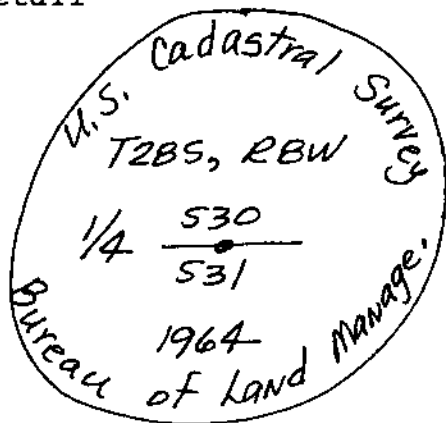

Monument Set (Procedures and Description)

None.

New Accessories

10" D. Fir BT, I scribed "1/4 531 BT" bears S 26° W,
6 1/2 feet.

16" D. Fir, I scribed "1/4 530 BT" bears
N 12 1/2° E, 63 1/2 feet.

Location & Comments

Surveyor's Seal

Corner is N 60° W ± Compass Declination 20 1/2° E

500 feet from where Firm/Agency

logging road crosses Shaner Engineering, Inc.

live stream. Address P.O. Box 1430

Roseburg, Oregon 97470

Party Chief B. Shaner

Notes " "

Witness Derrick Stave

REGISTERED
PROFESSIONAL
LAND SURVEYOR

Bruce A Shaner
OREGON
OCT. 4, 1957
BRUCE A. SHANER
490

EXPIRES 12-31-94¹⁶

C.S. File No. 63/153 C