

M 112-78

FILED <sup>36</sup>

JUL 23 1993

OREGON CORNER RESTORATION FORM

Section 30 Township 28S Range 8W

COUNTY SURVEYOR  
DOUGLAS COUNTY, ORE.

County Douglas Date \_\_\_\_\_

Corner Designation

1/4 S  
530 • 529

- Condition Report Only
- Not Found
- Renewed
- Unrecorded
- Surveyed In
- Referenced Out

Previous Renewals/Surveys, etc.


See Survey by Rev. Stuntzner, April 1977.

Monument(s) & Accessories Found: (Condition and Source)

I found a 5/8" x 34" Iron Rod w/ Plastic Cap, from which a:  
18" D. Fir BT stump (record 16"), scribes "BT" visible,  
bears N84°E (Record N79°E), 18.5 feet.  
16" Madrone BT (record 14"), scribe "1/4" visible,  
bears N75°W (record N81°W), 28.2 feet.

Monument Detail

Sketch

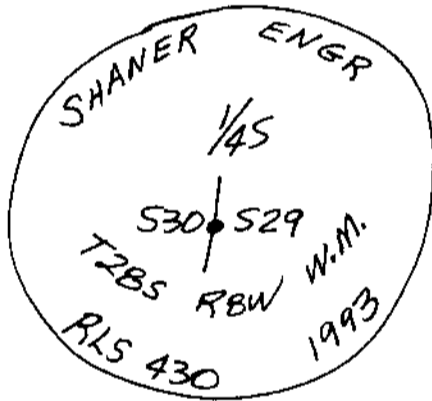

Monument Set (Procedures and Description)

I set a 2 1/2" Brass Cap, mounted on a 1" x 30"  
Iron Pipe, in place of the 5/8" iron rod & then placed  
Iron Rod alongside Brass Cap. See above detail for  
brass cap.

New Accessories

6" D. Fir BT, I scribed "1/4 529 BT", bears N80°E, 4.6 feet.  
14" Cedar BT, I scribed "1/4 529 BT", bears N62°E, 13.2 feet.  
8" W. Fir BT, " " "1/4 530 BT", bears S60°W, 8.2 feet.

Location & Comments

Corner is approx,  
1,000 feet West  
of logging road.

Compass Declination 20 1/2° E

Firm/Agency \_\_\_\_\_

Shaner Engineering, Inc.

Address P.O. Box 1430

Roseburg, Oregon 97470

Party Chief B. Shaner

Notes " "

Witness C.W. Berlier

John Wright

Surveyor's Seal

REGISTERED  
PROFESSIONAL  
LAND SURVEYOR

Bruce A Shaner

OREGON  
OCT. 4, 1957  
BRUCE A. SHANER  
430

EXPIRES 12-31-94

U.S. FILE NO. 63/153 20