

M 112-78

FILED JC

JUL 23 1993

OREGON CORNER RESTORATION FORM

Section 30 Township 28S Range 8W

COUNTY SURVEYOR
DOUGLAS COUNTY, ORE.

County Douglas Date July 15, '93

Corner Designation

Center 1/4 Section Corner

- Condition Report Only
- Not Found
- Renewed
- Unrecorded
- Surveyed In
- Referenced Out

Previous Renewals/Surveys, etc.


None of Record.

Monument(s) & Accessories Found: (Condition and Source)

This is a newly surveyed corner.

Monument Detail

Sketch

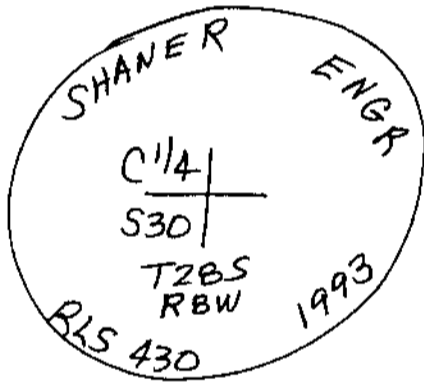

Monument Set (Procedures and Description)

I set a 2 1/2" Brass Cap on a 1" x 30" Galv. Iron Pipe, 24" in the ground, and from which a:

(I set a 6 feet Steel Fence Post South, 02 feet from Brass Cap)

New Accessories

- 10" D. Fir BT, I scribed "C1/4 S30 BT", bears S2°E, 24 1/2 feet.
- 12" D. Fir BT, I scribed "C1/4 S30 BT", bears S62°W, 20 3/4 feet.
- 6" D. Fir BT, I scribed "C1/4 S30 BT", bears N69°W, 16 1/2 feet.
- 10" D. Fir BT, " " " " " " , bears N23°E, 21 1/2 feet.

A found 1" x 30" Iron Pipe, bearing N22°W, 3 1/2 feet, was placed

Location & Comments

alongside Brass Cap.

Surveyor's Seal

Corner is 600 feet

Compass Declination 20 1/2° E

East from old

Firm/Agency

Mainline logging

Shaner Engineering

road.

Address PO Box 1430

Roseburg, OR 97470

Party Chief B. Shaner

Notes " "

Witness Jack Wright

REGISTERED
PROFESSIONAL
LAND SURVEYOR

Bruce A. Shaner

OREGON
OCT. 4, 1957
BRUCE A. SHANER
430

EXPIRES 12-31-94

Doc No. 63/153-21