

FILED JP

OREGON CORNER RESTORATION FORM


AUG 4 1993

Section 29 Township 31S Range 5W

COUNTY SURVEYOR
DOUGLAS COUNTY, ORE.

County Douglas Date July 21, '93

Corner Designation

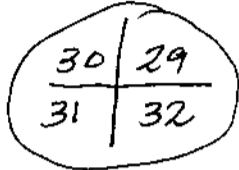

- Condition Report Only
- Not Found
- Renewed
- Unrecorded
- Surveyed In
- Referenced Out

Previous Renewals/Surveys, etc.


Corner Restored by Ore. State Board of Forestry in 1963.
" " " Douglas County Surveyor (Powell) in 1966.

Monument(s) & Accessories Found: (Condition and Source)

Found 3" Brass Cap on a 1 1/2" Iron Pipe, from which a:
26" D. Fir BT Stump, scribes visible, bears S13°W, 59 1/2 feet.
22" D. Fir BT, bears S74°E, 150 1/2 feet - Now Gone.
26" ~~22"~~ D. Fir BT Stump, scribes visible, bears N12°E, 122 feet.
12" Chinquapin BT (record 4"), face healed over, bears N82°E
(record N79°E) 232 feet.
22" D. Fir BT (record 5"), face overgrown, bears S8°E, 82 1/2 feet.
18" D. Fir BT, face overgrown, (record 5"), bears S84°W (Record S80°W),

Monument Detail

Sketch 70 1/2 feet

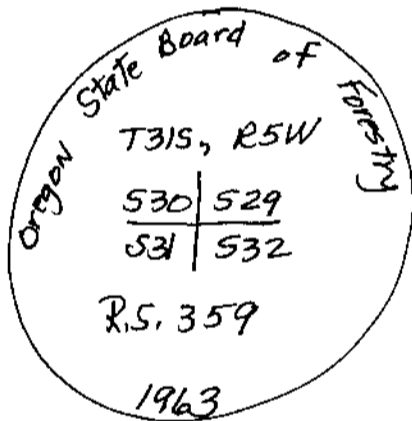

Monument Set (Procedures and Description)

N/A - None.

~~New Accessories~~

I found a ¹⁰" D. Fir BT, face overgrown, BLM Tag, bears
N19°W, 74 feet. (~~This BT not of previous record.~~)

Location & Comments

Corner sets
on North bank
of an active
logging road that
runs East-West.

Compass Declination 20 1/2° E

Firm/Agency Shaner Engineering, Inc.

Address P.O. Box 1430

Roseburg, Oregon 97470

Party Chief B. Shaner

Notes " "

Witness Jack Wright

Surveyor's Seal

REGISTERED
 PROFESSIONAL
 LAND SURVEYOR

Bruce A Shaner

OREGON
 OCT. 4, 1957
 BRUCE A. SHANER
 430

Expires Dec. 31, '94
 A.C. File No. 63/153-