

R.M. 3-79

FILED JP

OREGON CORNER RESTORATION FORM

SEP 2 1993

Section 16 Township 29S Range 4W

COUNTY SURVEYOR  
DOUGLAS COUNTY, ORE.

County Douglas Date Aug. 28, '93

Corner Designation

$\frac{1}{4}$   $\frac{59}{516}$

- Condition Report Only
- Not Found
- Renewed
- Unrecorded
- Surveyed In
- Referenced Out

Previous Renewals/Surveys, etc.


W.H. Weed, Deputy County Surveyor, 1925; J. Markham, 1956;  
U.S.B.L.M., 1969.

Monument(s) & Accessories Found: (Condition and Source)

Found 3/4" Brass Cap on a 2 1/2" Iron Pipe, from which a:  
20" D. Fir BT, face overgrown, bears N24°E, 245.5 feet.  
10" Oak BT, " " , bears S9°W (record S4°E), 29.0 feet.  
(BT now dead E.)  
16" Madrone BT, face overgrown, bears N53°W, 57.1 feet.  
36" D. Fir BT, " " , bears S14°W, 58.1 feet.

Monument Detail

Sketch

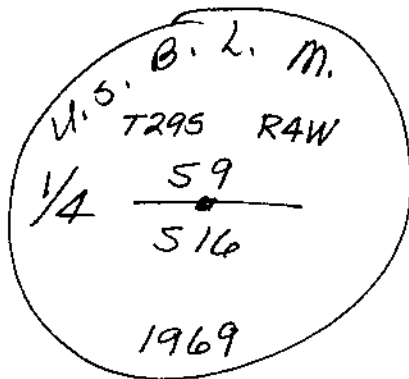

Monument Set (Procedures and Description)

None.

New Accessories

None.

Location & Comments

On East-West  
fence line, about  
1 chain West of  
dirt access road.

Compass Declination 20 1/2° E

Firm/Agency Shaner

Address P.O. Box 1430

Roseburg, OR 97470

Party Chief B. Shaner

Notes "

Witness J. Wright

Surveyor's Seal

REGISTERED  
PROFESSIONAL  
LAND SURVEYOR

Bruce A. Shaner

OREGON  
OCT. 4, 1957  
BRUCE A. SHANER  
430

Expires Dec. 31, 194.

C.S. File No. 63/153-24