

R.M. 3-79

FILED *JP*

OREGON CORNER RESTORATION FORM


SEP 2 1993

Section 16 Township 29S Range 4W

COUNTY SURVEYOR
DOUGLAS COUNTY, ORE.

County Douglas Date Aug. 28, '93

Corner Designation

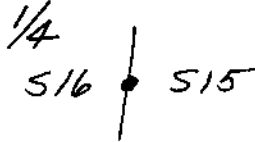

- Condition Report Only
- Not Found
- Renewed
- Unrecorded
- Surveyed In
- Referenced Out


Previous Renewals/Surveys, etc. U.S.B.L.M., 1969.

Monument(s) & Accessories Found: (Condition and Source)

Found 3 1/4" Brass Cap on a 2 1/2" Iron Pipe, from which a:
24" D. Fir BT, face over grown, bears N62°E, 66.7 feet,
24" Cedar BT, " " , bears S20°W, 100.9 feet,
(record 75.2 feet),

Monument Detail

Sketch

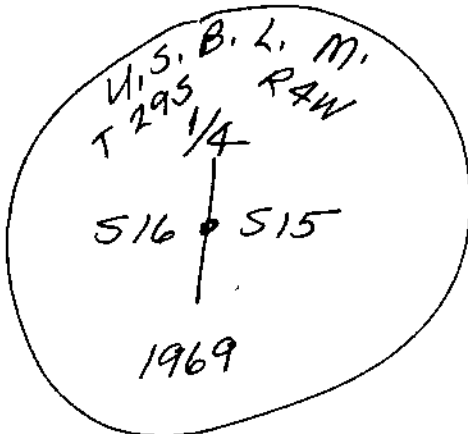

Monument Set (Procedures and Description)

None.

New Accessories

None.

Location & Comments

Located on newer
North - South fence
line.
Note 1 BT
discrepancy.

Compass Declination 20 1/2° E
 Firm/Agency Shaner
Engineering, Inc.
 Address P.O. Box 1430
Roseburg, OR 97470
 Party Chief B. Shaner
 Notes " "
 Witness J. Wright
D. Stone

Surveyor's Seal

REGISTERED
PROFESSIONAL
LAND SURVEYOR

Bruce A Shaner

OREGON
OCT. 4, 1957
BRUCE A. SHANER
430

Expires Dec. 31, 1994