

R.M. 3-79

FILED JP


OREGON CORNER RESTORATION FORM
Donation Land Claim No. 38
Section 21 Township 29S Range 4W

SEP 2 1993

COUNTY SURVEYOR
DOUGLAS COUNTY, ORE.

County Douglas Date Aug. 28, '93

Corner Designation

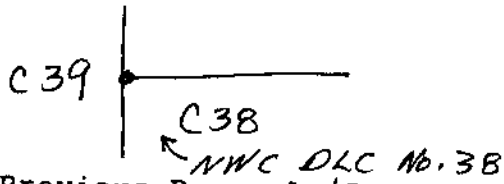

- Condition Report Only
- Not Found
- Renewed
- Unrecorded
- Surveyed In
- Referenced Out

Previous Renewals/Surveys, etc.


Deputy County Surveyor Beyer, 1938; J. Markham, 1956;
U.S.B.L.M., 1969

Monument(s) & Accessories Found: (Condition and Source)

Found 3/4" Brass Cap on a 2 1/2" Iron Pipe, from which a;
22" D. Fir BT, face overgrown, bears N20°E, 33.5 feet.
20" W. Oak BT, " " , bears S36 1/2°W, 56.9 feet.

Monument Detail

Sketch

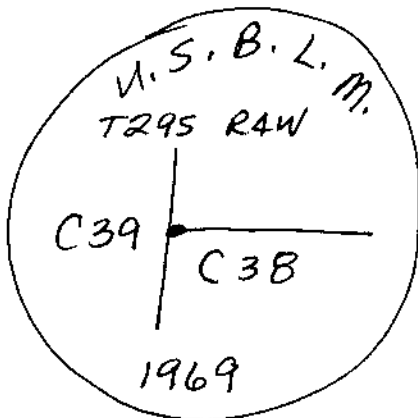

Monument Set (Procedures and Description)

None.

New Accessories

None.

Location & Comments

Found on North -
South Fence line.

Compass Declination 20 1/2° E

Firm/Agency Shaner

Engineering, Inc

Address P.O. Box 1430

Roseburg, Oregon 97470

Party Chief B. Shaner

Notes " "

Witness J. Wright

D. Stone

Surveyor's Seal

REGISTERED
PROFESSIONAL
LAND SURVEYOR

Bruce A. Shaner

OREGON
OCT. 4, 1957
BRUCE A. SHANER
430

Expires Dec. 31, '94.

C.S. File No. 63/153