

R.M. 3-79

FILED *J*

SEP 2 1993

OREGON CORNER RESTORATION FORM  
Devotion Land Claims No. 38 & 39  
Section 21 Township 29S Range 4W

COUNTY SURVEYOR  
DOUGLAS COUNTY, ORE.

County Douglas Date Aug. 28, '93

Corner Designation

C39 | C38  
521

- Condition Report Only
- Not Found
- Renewed
- Unrecorded
- Surveyed In
- Referenced Out

Previous Renewals/Surveys, etc.


Deputy County Surveyor Boyer, 1938; Deputy County Surveyor  
Byron, 1963; U.S.B.L.M., 1969.

Monument(s) & Accessories Found: (Condition and Source)

Found a 3/4" Brass Cap on a 2 1/2" Iron Pipe, from which a:  
26" D. Fir BT, face overgrown, bears N41°W, 52.2 feet.  
16" D. Fir BT, " " " " , bears NB5°E, 67.3 feet.

Monument Detail

Sketch

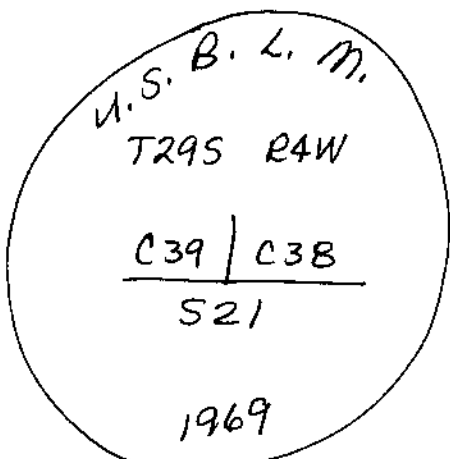

Monument Set (Procedures and Description)

None.

New Accessories

None.

Location & Comments

At Fence Corner. Compass Declination 20 1/2° E  
North Fence Runs Firm/Agency Shaner  
North & West. Very Engineering, Inc.  
old fence goes East. Address P.O. Box 1430  
Roseburg, Oregon  
 Party Chief B. Shaner  
 Notes " "  
 Witness J. Wright  
D. Stone

Surveyor's Seal

REGISTERED  
PROFESSIONAL  
LAND SURVEYOR

Bruce A. Shaner

OREGON  
OCT. 4, 1957  
BRUCE A. SHANER  
430

Expires Dec. 31, '94  
C.S. File No. 63/153