

R.M. 3-79

FILED JP

OREGON CORNER RESTORATION FORM


SEP 2 1993

Donation Land Claim No. 39
Section 16 Township 29S Range 4W

COUNTY SURVEYOR
DOUGLAS COUNTY, ORE.

County Douglas Date Aug. 28, 1993

Corner Designation

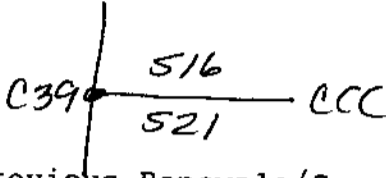

- Condition Report Only
- Not Found
- Renewed
- Unrecorded
- Surveyed In
- Referenced Out

Previous Renewals/Surveys, etc. U.S. B.L.M. 1969

Monument(s) & Accessories Found: (Condition and Source)
Same as U.S. B.L.M. Record.

Monument Detail

Sketch

Monument Set (Procedures and Description)
None

New Accessories
None

Location & Comments

Located on
North-South
Fence Line.

Compass Declination 20 1/2° E
Firm/Agency Shaner
Engineering, Inc.
Address P.O. Box 1430
Roseburg, OR 97470
Party Chief B. Shaner
Notes " "
Witness J. Wright

Surveyor's Seal

REGISTERED
PROFESSIONAL
LAND SURVEYOR

Bruce A. Shaner

OREGON
OCT. 4, 1957
BRUCE A. SHANER
430

Expires Dec. 31, 1994.
C.S. File No. 63/153-
34