

FILED *JP*

OCT 26 1993

COUNTY SURVEYOR  
DOUGLAS COUNTY, ORE.

OREGON CORNER RESTORATION FORM

Section 19 Township 29S Range 7W

County DOUGLAS Date 10-4-93

Corner Designation

E  $\frac{1}{4}$  of SEC 19

- Condition Report Only
- Not Found
- Renewed
- Unrecorded
- Surveyed In
- Referenced Out

Previous Renewals/Surveys, etc. BLM SURVEY  
1988-1989, REN - 215


Monument(s) & Accessories Found: (Condition and Source)

- 1924 IRON PIPE BRASS CAP - GOOD
- BTS: FIR STUMP S68W 6 LKS - POOR
- 21" CEDAR N20 $\frac{1}{2}$ W 35 $\frac{1}{2}$  - TALL STUMP - TAG NAILED TO TOP OF STUMP
- 13" FIR SNAG N17 $\frac{1}{2}$ W 34 $\frac{1}{2}$  - TALL STUMP - TAG NAILED TO TOP OF STUMP
- 13" FIR S78 $\frac{1}{4}$ E 93 LKS - GOOD - HEALED FACE

Monument Detail

$\frac{1}{4}$   
S19/S20  
1924

Sketch

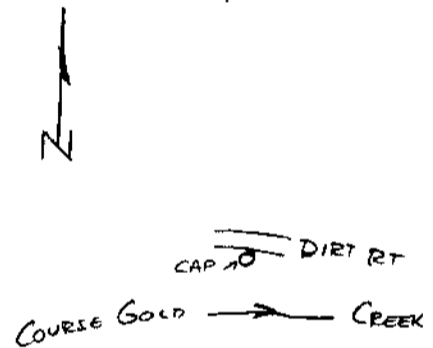

Monument Set (Procedures and Description)

---



---



---



---

New Accessories

- BTS: 10" FIR N4E 30 $\frac{1}{2}$  SCRIBED " $\frac{1}{4}$  BT"
- 12" FIR N6E 31 $\frac{1}{2}$  SCRIBED " $\frac{1}{4}$  BT"
- 11" ALDER S80E 28 $\frac{1}{2}$  SCRIBED " $\frac{1}{4}$  BT"

Location & Comments

Compass Declination 20 $\frac{1}{2}$

Firm/Agency ROSEBURG FOREST PRODUCTS


Address P.O. BOX 1088  
ROSEBURG, 97470

Party Chief \_\_\_\_\_

Notes \_\_\_\_\_

Witness \_\_\_\_\_

Surveyor's Seal

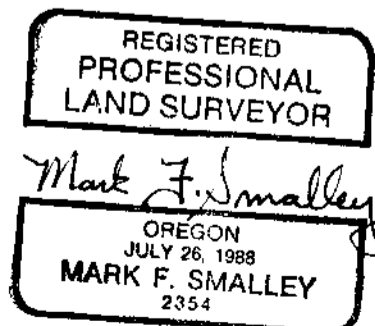

REN = 297