

FILED JP

OREGON CORNER RESTORATION FORM

OCT 26 1993

Section 19 Township 29S Range 7W

COUNTY SURVEYOR  
DOUGLAS COUNTY, ORE.

County DOUGLAS Date 10-4-93

Corner Designation

S 1/16 between 19 & 20

- Condition Report Only
- Not Found
- Renewed
- Unrecorded
- Surveyed In
- Referenced Out

Previous Renewals/Surveys, etc. RLM SURVEY  
1988-1989

Monument(s) & Accessories Found: (Condition and Source)

IRON PIPE BRASS CAP - GOOD LEANS NORTH  
BTS: 13" FIR N4 1/2 E 54 LKS - 6' TALL STUMP  
30" FIR S14W 67 1/2 LKS - GOOD - PART HEALED FACE

Monument Detail

Sketch

S 1/16  
 S 19/S20  
 1988

Monument Set (Procedures and Description)

New Accessories

NEW BT SET 8" FIR S58W 39 3/4 SCRIBED "1/16 BT"

Location & Comments

Surveyor's Seal

Compass Declination \_\_\_\_\_

Firm/Agency ROSEBURG FOREST PRODUCTS


Address P.O. Box 2088

ROSEBURG 97470

Party Chief Bill Olson

Notes \_\_\_\_\_

Witness \_\_\_\_\_

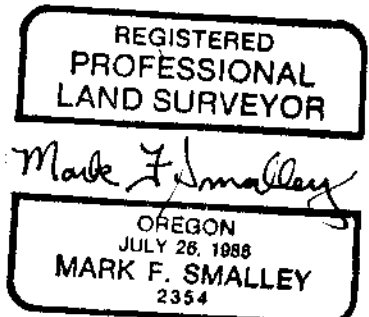

C.S. File No. 63/153

EXP. 12-31-94-45 C

2088-20  
298  
14